

STATE OF MICHIGAN
DEPARTMENT
OF
NATURAL RESOURCES

LAND CORNER RECORD


MISSAUKIE COUNTY
T 24 N R 6 W

DESCRIPTION OF CORNER E 1/4 Corner, Section 7

CORNER MONUMENT Set DNR Mon.

DATE MONUMENT PLACED AND WITNESSED 8-12-71

WITNESSES TO CORNER..... 12" Maple N 61 W 91.0'

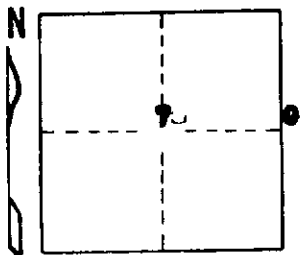

12" Maple N 58 E 57.7'


9" Ironwood S 48 W 85.3'

AND
Ctr. N-S Co. Rd Due W 2'

CIRCLE CORNER REGISTERED

DESCRIPTION IN DETAIL AS TO HOW CORNER WAS LOCATED AND IDENTIFIED OR RESTORED.

Corner reestablished per BLM standard instructions.

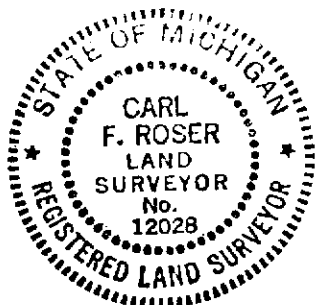

SURVEYOR'S SEAL

SIGNED Carl F. Roser DATE 8-19-71
REGISTERED LAND SURVEYOR
12028

DISTRIBUTION:

County Courthouse
Area Forester (Regions I & II)
District or Region Surveyor
Forestry Div., Lansing

R 4047
Rev. 10/68