

✓

STATE OF MICHIGAN
DEPARTMENT
OF
NATURAL RESOURCES

LAND CORNER RECORD

MISSAUKEE COUNTY


T 24 N R 6 W

DESCRIPTION OF CORNER SE corner, Section 7

CORNER MONUMENT Found 1/2" pipe

DATE MONUMENT PLACED AND WITNESSED 8-10-71

WITNESSES TO CORNER..... P. Fols N 41 E 129.8'

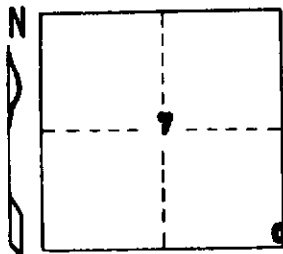

2 1/2" Elm N 43 W 51.35'

8" Twin Cherry S 76 E 150.78'


AND Ctr. Co. Rd E-W Due N 6'

Ctr. Co. Rd N-S Due E 3'

CIRCLE CORNER REGISTERED

DESCRIPTION IN DETAIL AS TO HOW CORNER WAS LOCATED AND IDENTIFIED OR RESTORED.

**Found 1/2" pipe which fits occupancy and is of record, Pg. 31 of U.S. notes
(Haver Wit.) at Co. Rd. Comm.**

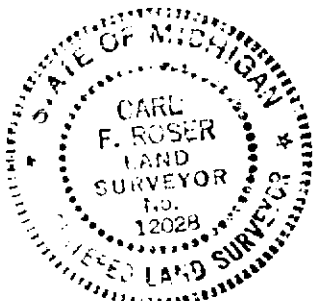

SURVEYOR'S SEAL

SIGNED Carl F. Roser DATE 8-17-71

REGISTERED LAND SURVEYOR
12028

DISTRIBUTION:

County Courthouse
Area Forester (Regions I & II)
District or Region Surveyor
Forestry Div., Lansing

R 4047
Rev. 10/68