


STATE OF MICHIGAN  
DEPARTMENT  
OF  
NATURAL RESOURCES

LAND CORNER RECORD

MISSAUKEE COUNTY  
T 24 N R 6 W

DESCRIPTION OF CORNER NW corner Section 6  
CORNER MONUMENT Re-witnessed Exist. Dept. Mon.  
DATE MONUMENT PLACED AND WITNESSED 7-20-71  
WITNESSES TO CORNER..... 4" W. Pine S 60 W 40.7'

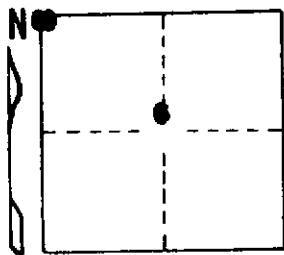


4" W. Pine N 60 W 47.2'  
4" W. Pine N 85 E 71.2'  
AND Ctr. N-S Trail Rd. Due E 44'  
Ctr. E-W Trail Rd. Due S 115'

CIRCLE CORNER REGISTERED

DESCRIPTION IN DETAIL AS TO HOW CORNER WAS LOCATED AND IDENTIFIED OR RESTORED.

Existing DNR monument previously set to perpetuate Schanf's corner which was a restored U.S. corner by 1/4 corner and line tree to East, June 1940.

Note: A 1 1/2"x1 1/2" pipe encased in Concrete is 120' South & 14' East from DNR Monument. This is an old Cavanaugh corner of record at the County Road Comm. dating back to about 1909.

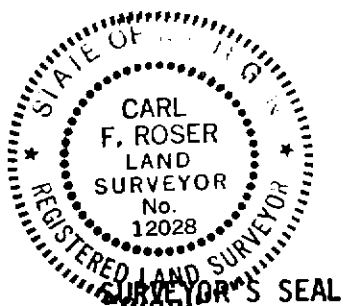

*Carl F. Roser*

SIGNED

REGISTERED LAND SURVEYOR

DATE

8-5-71

DISTRIBUTION:

County Courthouse  
Area Forester (Regions I & II)  
District or Region Surveyor  
Forestry Div., Lansing

R 4047  
Rev. 10/68