


STATE OF MICHIGAN  
DEPARTMENT  
OF  
NATURAL RESOURCES  
LAND CORNER RECORD

MISSAUKEE COUNTY  
T 24 N R 6 W

DESCRIPTION OF CORNER N 1/4 corner, Section 1  
CORNER MONUMENT Set DNR Monument  
DATE MONUMENT PLACED AND WITNESSED 7-26-71  
WITNESSES TO CORNER..... 15" W. Pine Stump S 22 W 35.7'

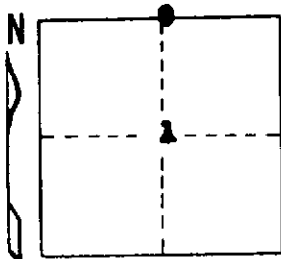

20" Oak N 9 E 27.2'  
12" S. Cherry N 49 W 101.2'  
AND  
Ctr. L. E-W Dirt Trail Due S. 4'


CIRCLE CORNER REGISTERED

DESCRIPTION IN DETAIL AS TO HOW CORNER WAS LOCATED AND IDENTIFIED OR RESTORED.

**No remaining U.S. evidence at this date.**

**Corner reestablished per B.L.N. instructions.**

**Removed Dept. Monument at Schaaf position for corner. Not properly set.**

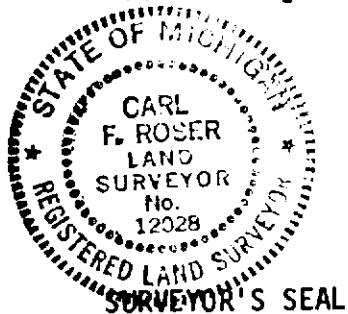

SIGNED

*Carl F. Roser*  
REGISTERED LAND SURVEYOR **12028**

DATE

8-2-71

DISTRIBUTION:

County Courthouse  
Area Forester (Regions I & II)  
District or Region Surveyor  
Forestry Div., Lansing

R 4047  
Rev. 10/68