

STATE OF MICHIGAN  
DEPARTMENT  
OF  
NATURAL RESOURCES

LAND CORNER RECORD


MISSAURKE COUNTY  
T 26 N R 6 W

DESCRIPTION OF CORNER NE Corner, Section 1

CORNER MONUMENT Re-Vit Exist. BNR Mon.

DATE MONUMENT PLACED AND WITNESSED 7-20-71

WITNESSES TO CORNER..... 12" Oak N 44 E 49.5'

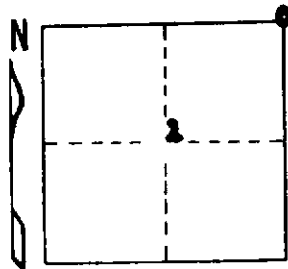


12" Oak S 41 E 51.9'  
10" Oak N 37 W 66.6'

AND In C.L. Fire Lane North  
C.L. Fire Lane E-W Due N 2'  
C.L. Fire Lane S. Due E 230'

CIRCLE CORNER REGISTERED

DESCRIPTION IN DETAIL AS TO HOW CORNER WAS LOCATED AND IDENTIFIED OR RESTORED.

**Existing BNR monument previously set to perpetuate Schaaf's corner which was a restored U.S. corner by U.S.B.T. Stumps, June 1940.**

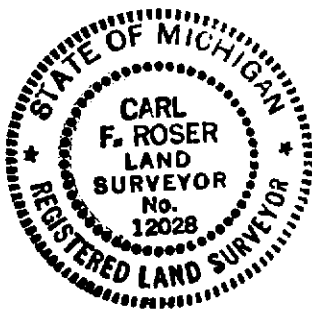

SURVEYOR'S SEAL

SIGNED Carl F. Roser DATE 8-4-71  
REGISTERED LAND SURVEYOR #12028

DISTRIBUTION:

County Courthouse  
Area Forester (Regions I & II)  
District or Region Surveyor  
Forestry Div., Lansing

R 4047  
Rev. 10/68