

STATE OF MICHIGAN
DEPARTMENT
OF
NATURAL RESOURCES

LAND CORNER RECORD


WISBAUKEE COUNTY
T 24 N R 6 W

DESCRIPTION OF CORNER W 1/4 corner, Section 1

CORNER MONUMENT Set DNR Monument

DATE MONUMENT PLACED AND WITNESSED 9-22-71

WITNESSES TO CORNER..... 20" Oak N 80 E 29.1'

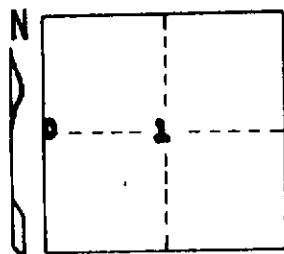

14" Oak N 08 E 18.7'

20" Oak N 50 W 17.7'

AND N-S Road. Due W 12'

CIRCLE CORNER REGISTERED


DESCRIPTION IN DETAIL AS TO HOW CORNER WAS LOCATED AND IDENTIFIED OR RESTORED.

Found remains of following listed USBTs from which we were able to locate a stake hole.

W. Pine stp. 12" S 40 E 16.8'
(lower face with scribes, plain)

Maple stp remains N 35 W 17.1'
(suckers)

Restored corner from U.S. Witness noted above.

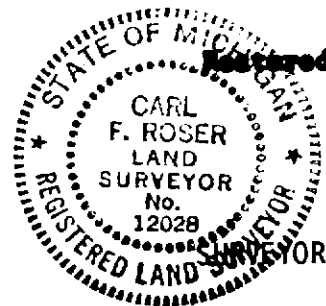

SIGNED Carl F. Roser DATE 9-29-71
REGISTERED LAND SURVEYOR 12028

DISTRIBUTION:

County Courthouse
Area Forester (Regions I & II)
District or Region Surveyor
Forestry Div., Lansing

R 4047
Rev. 10/68