


STATE OF MICHIGAN  
DEPARTMENT  
OF  
NATURAL RESOURCES

LAND CORNER RECORD

MISSAUKEE COUNTY  
T 24 N R 6 W

DESCRIPTION OF CORNER SE corner Sec. 6  
CORNER MONUMENT Re-Wit. Exist. Dept. Mon. (1" pipe - no cap)  
DATE MONUMENT PLACED AND WITNESSED 7-28-71


WITNESSES TO CORNER.....	<u>12" Oak</u>	<u>N 78 W</u>	<u>52.8'</u>
	<u>8" W. Pine</u>	<u>S 71 E</u>	<u>82.9'</u>
	<u>18" Oak</u>	<u>S 15 E</u>	<u>90.7'</u>
	<u>5" Faced Cedar post</u>	<u>Due E</u>	<u>22'</u>
AND	<u>Ctr. N-S Rd.</u>	<u>Due W</u>	<u>8'</u>

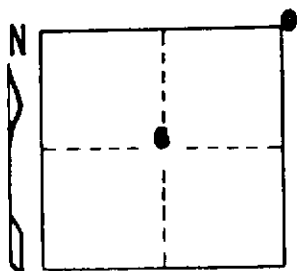

CIRCLE CORNER REGISTERED

DESCRIPTION IN DETAIL AS TO HOW CORNER WAS LOCATED AND IDENTIFIED OR RESTORED.

**exist. DNR mon. previously set to perpetuate Schauf's corner, which was a restored U.S. corner by one U.S.B.T. site, July 1940.**

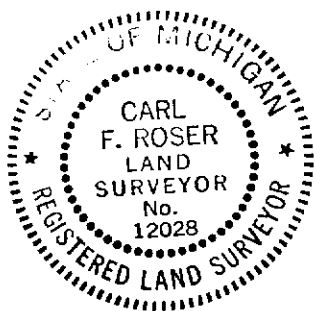

SURVEYOR'S SEAL

SIGNED Carl F. Roser DATE 8-5-71  
REGISTERED LAND SURVEYOR 12028

DISTRIBUTION:

County Courthouse  
Area Forester (Regions I & II)  
District or Region Surveyor  
Forestry Div., Lansing

R 4047  
Rev. 10/68