


STATE OF MICHIGAN
DEPARTMENT
OF
NATURAL RESOURCES

LAND CORNER RECORD

MISSAUKEE COUNTY
T 24 N R 6 W

DESCRIPTION OF CORNER N 1/4 corner, Section 6
CORNER MONUMENT Re-Wit. Exist. Dept. Mon.
DATE MONUMENT PLACED AND WITNESSED 7-29-71

WITNESSES TO CORNER..... 14" R. Pine S 83 E 64.0'

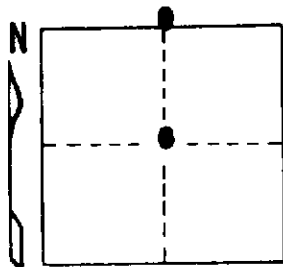

9" R. Pine N 87 E 45.9'


8" R. Pine N 45 W 105.0'

AND

CIRCLE CORNER REGISTERED

DESCRIPTION IN DETAIL AS TO HOW CORNER WAS LOCATED AND IDENTIFIED OR RESTORED.

Exist. DNR monument previously set to perpetuate Schaaf corner which was a restored U.S. corner by one U.S.B.T. site and a line tree site and slab showing good set of notches to West, June 1940.

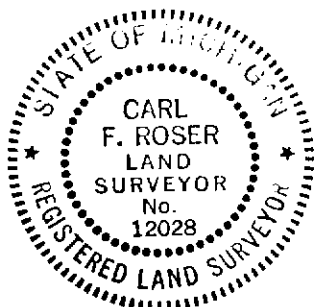

SURVEYOR'S SEAL

SIGNED Carl F. Roser DATE 8-5-71
REGISTERED LAND SURVEYOR 12028

DISTRIBUTION:

County Courthouse
Area Forester (Regions I & II)
District or Region Surveyor
Forestry Div., Lansing

R 4047
Rev. 10/68