

STATE OF MICHIGAN
DEPARTMENT
OF
NATURAL RESOURCES


LAND CORNER RECORD

MISSAUKEE COUNTY
T 24 N R 6 W

DESCRIPTION OF CORNER NE Corner, Section 5
CORNER MONUMENT Re-Wit. Exist. Dept. Mon in E-W Fire Lane opening.
DATE MONUMENT PLACED AND WITNESSED 7-29-71

WITNESSES TO CORNER.....

<u>10" Oak</u>	<u>N 45 W</u>	<u>25.5'</u>
<u>10" Oak</u>	<u>S 98 E</u>	<u>30.5'</u>
<u>12" Oak</u>	<u>N 80 E</u>	<u>37.5'</u>
<u>8" Oak</u>	<u>S 72 E</u>	<u>60.2'</u>
<u>Random S</u>	<u>Due W</u>	<u>1.4'</u>

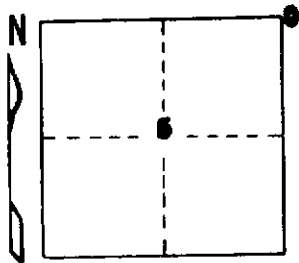


AND

CIRCLE CORNER REGISTERED

DESCRIPTION IN DETAIL AS TO HOW CORNER WAS LOCATED AND IDENTIFIED OR RESTORED.

Exist. DNR Mon. previously set to perpetuate Schaaf's Corner, which was a restored U.S. corner by USBT stamps, July 1940.

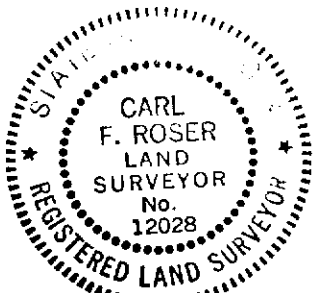

SURVEYOR'S SEAL

Carl F. Roser

SIGNED

DATE

8-5-71

DISTRIBUTION:

REGISTERED LAND SURVEYOR **MEH 12028**

County Courthouse
Area Forester (Regions I & II)
District or Region Surveyor
Forestry Div., Lansing

R 4047
Rev. 10/68