


STATE OF MICHIGAN  
DEPARTMENT  
OF  
NATURAL RESOURCES

LAND CORNER RECORD

T 24 N R 6 W

DESCRIPTION OF CORNER N 1/4 corner, Section 5  
CORNER MONUMENT Set Std. Dept. Monument  
DATE MONUMENT PLACED AND WITNESSED 5-8-71

WITNESSES TO CORNER. Map N.D. To 12" W. Pine N 80 E 78.0'

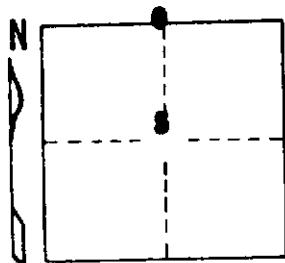

8" W. Pine N 09 E 27.0'


20" W. Pine S 55 W 88.7'

AND

CIRCLE CORNER REGISTERED

DESCRIPTION IN DETAIL AS TO HOW CORNER WAS LOCATED AND IDENTIFIED OR RESTORED.

This corner was reestablished during a retracement survey in this area. Found Dept. Mon. as set at position of Schaaf corner, dated 1940. Schaaf attempted to set the corner by proportionate measurement between Section Corners to E & W but was too far West by some 200 ft. We do agree closely with his measurement of the E line of Sec. 5. Our position for the 1/4 corner is based on a survey of Sec. 5 (24-6) dated 1900, which is on record in old Co. Surveyors book at the Missaukee Co. Mi. Comm. Found both witnesses: W.P.S. 22, N 80 E 14.5' and W.P.S. 18, N 40 W, 29.7'. The 1/4 corner by these witnesses fits the split of the mile within less than 4' and also fits the U.S. tie (1899) survey East to small pond of 2 chains.

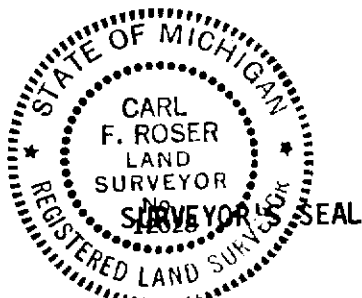

SIGNED Carl F. Roser DATE 5-10-71  
REGISTERED LAND SURVEYOR 12028

DISTRIBUTION:

County Courthouse  
Area Forester (Regions I & II)  
District or Region Surveyor  
Forestry Div., Lansing

R 4047  
Rev. 10/68