

STATE OF MICHIGAN
DEPARTMENT
OF
NATURAL RESOURCES

LAND CORNER RECORD


MISSAUKEE COUNTY
T 24 N R 6 W

DESCRIPTION OF CORNER E 1/4 corner, Section 5

CORNER MONUMENT Set BLM monument & post

DATE MONUMENT PLACED AND WITNESSED 8-19-71

WITNESSES TO CORNER..... 12" Cedar N 45 W 8.5'

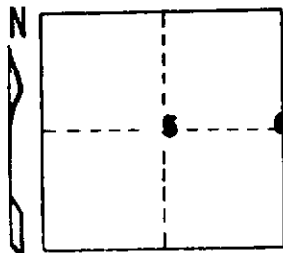

10" Cedar S 1 E 8.5'


10" Cedar twin N 59 E 18.1'

AND N-S Road Due W. 0.7'

CIRCLE CORNER REGISTERED

DESCRIPTION IN DETAIL AS TO HOW CORNER WAS LOCATED AND IDENTIFIED OR RESTORED.

Corner established per B.L.M. instructions.

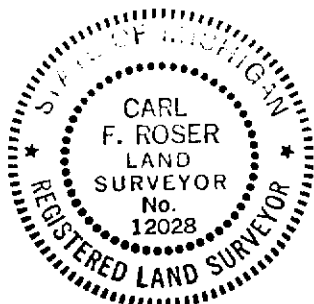

SURVEYOR'S SEAL

SIGNED Carl F. Roser DATE 8-20-71
REGISTERED LAND SURVEYOR **12028**

DISTRIBUTION:

County Courthouse
Area Forester (Regions I & II)
District or Region Surveyor
Forestry Div., Lansing

R 4047
Rev. 10/68