


STATE OF MICHIGAN
DEPARTMENT
OF
NATURAL RESOURCES

LAND CORNER RECORD

MISMAUKE COUNTY
T 24 N R 6 W

DESCRIPTION OF CORNER NE Corner, Section 4
CORNER MONUMENT Set Std. Dept. Man at Schaaf position for corner.
DATE MONUMENT PLACED AND WITNESSED 7-28-71
WITNESSES TO CORNER..... 15" Oak S 15 W 40.8'

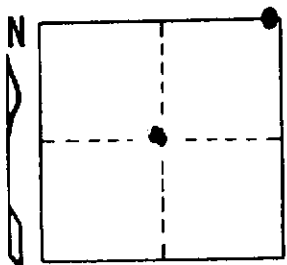


14" Oak N 30 W 37.1'
9" Oak N 44 E 21.9'
AND Ctr. of over-grown fire lane Due S. 11'

CIRCLE CORNER REGISTERED

DESCRIPTION IN DETAIL AS TO HOW CORNER WAS LOCATED AND IDENTIFIED OR RESTORED.

Restored corner from Schaaf witness U.F.S. NW & NE. Schaaf corner was restored U.S. corner per U.S.B.T. remains, July 1949.

We removed an old L.E.S. corner (faced Cedar post) which was 11' S. and 30' W of Schaaf's corner.

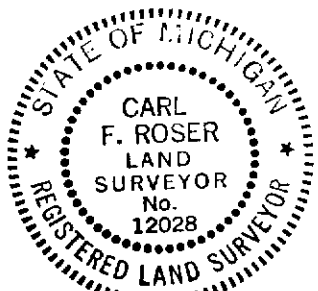

SURVEYOR'S SEAL

SIGNED

Carl F. Roser
REGISTERED LAND SURVEYOR 12028

DATE

8-5-71

DISTRIBUTION:

County Courthouse
Area Forester (Regions I & II)
District or Region Surveyor
Forestry Div., Lansing

R 4047
Rev. 10/68