

STATE OF MICHIGAN
DEPARTMENT
OF
NATURAL RESOURCES

LAND CORNER RECORD


MISSAUKEE COUNTY
T 24 N R 6 W

DESCRIPTION OF CORNER W 1/16 corner on S line, Section 4

CORNER MONUMENT Set 1" x 36" pipe

DATE MONUMENT PLACED AND WITNESSED 9-14-71

WITNESSES TO CORNER..... 9" Cedar N 6 W 14.8'

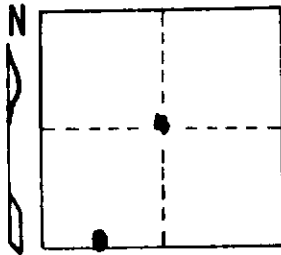

12" Cedar S 82 W 27.8'


6" Balsam S 17 E 30.9'

AND E-W Rand. Due S 20'

CIRCLE CORNER REGISTERED

DESCRIPTION IN DETAIL AS TO HOW CORNER WAS LOCATED AND IDENTIFIED OR RESTORED.

Corner established per S.L.M. instructions.

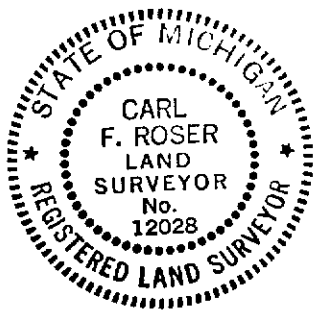

SURVEYOR'S SEAL

SIGNED Carl F. Roser DATE 9-21-71
REGISTERED LAND SURVEYOR 12028

DISTRIBUTION:

County Courthouse
Area Forester (Regions I & II)
District or Region Surveyor
Forestry Div., Lansing

R 4047
Rev. 10/68