

STATE OF MICHIGAN
DEPARTMENT
OF
NATURAL RESOURCES

LAND CORNER RECORD


WISBAUKE COUNTY
T 24 N R 6 W

DESCRIPTION OF CORNER N 1/4 corner, Section 3

CORNER MONUMENT Re-Vit. Exist. Dept. Mon.

DATE MONUMENT PLACED AND WITNESSED 7-20-71

WITNESSES TO CORNER..... 12" R. Pine 6 59 W 46.7'

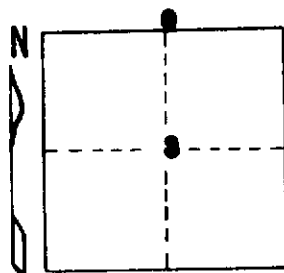

12" R. Pine N 56 W 23.2'

9" R. Pine N 23 E 46.8'


AND

Cap. in C.L. E-W Pine Line

CIRCLE CORNER REGISTERED

DESCRIPTION IN DETAIL AS TO HOW CORNER WAS LOCATED AND IDENTIFIED OR RESTORED.

Existing DNR monument previously set to perpetuate Schaaf's corner which was a restored U.S. Corner by U.S.B.T.S, June 1940.

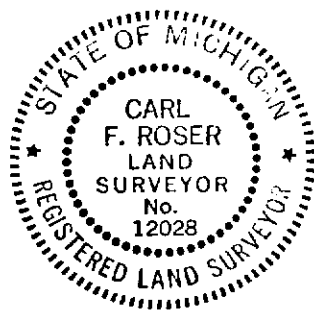

SURVEYOR'S SEAL

Carl F. Roser

SIGNED

REGISTERED LAND SURVEYOR **12028**

DATE

8-4-71

DISTRIBUTION:

County Courthouse
Area Forester (Regions I & II)
District or Region Surveyor
Forestry Div., Lansing

R 4047
Rev. 10/68