

STATE OF MICHIGAN
DEPARTMENT
OF
NATURAL RESOURCES

LAND CORNER RECORD


MISSAUKEE COUNTY
T 24 N R 6 W

DESCRIPTION OF CORNER S 1/4 corner, Section 3

CORNER MONUMENT Set DNR Monument

DATE MONUMENT PLACED AND WITNESSED 9-18-71

WITNESSES TO CORNER..... 11" B. Oak S 20 E 88.8'

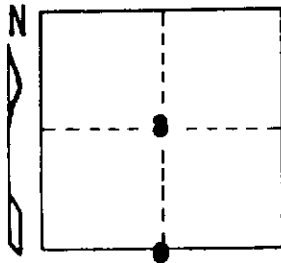

9" B. Oak N 20 W 55.3'

12" W. Oak N 56 E 103.6'


AND

CIRCLE CORNER REGISTERED

DESCRIPTION IN DETAIL AS TO HOW CORNER WAS LOCATED AND IDENTIFIED OR RESTORED.

No remaining U.S. evidence at this date.

Corner reestablished per B.L.N. instructions.

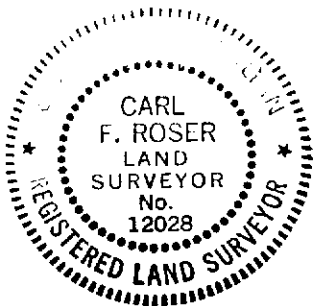

SURVEYOR'S SEAL

SIGNED Carl F. Roser DATE 9-20-71
REGISTERED LAND SURVEYOR
12028

DISTRIBUTION:

County Courthouse
Area Forester (Regions I & II)
District or Region Surveyor
Forestry Div., Lansing

R 4047
Rev. 10/68