

STATE OF MICHIGAN
DEPARTMENT
OF
NATURAL RESOURCES

LAND CORNER RECORD


MISSAUKEE COUNTY
T 24 N R 6 W

DESCRIPTION OF CORNER S 1/16 corner on W. line, Section 2

CORNER MONUMENT Set 1"x36" pipe

DATE MONUMENT PLACED AND WITNESSED 9-14-71

WITNESSES TO CORNER..... 10" Cedar N 24 E 8.6'

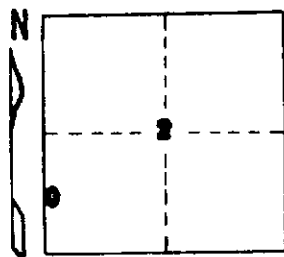

7" Cedar N 89 E 12.6'


6" Cedar N 31 W 17.2'

AND N-S Rand. Due W. 13'

CIRCLE CORNER REGISTERED

DESCRIPTION IN DETAIL AS TO HOW CORNER WAS LOCATED AND IDENTIFIED OR RESTORED.

Corner established per B.L.M. instructions.

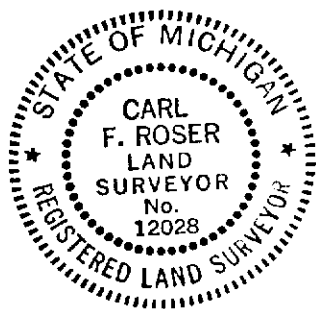

SURVEYOR'S SEAL

SIGNED Carl F. Roser DATE 9-21-71
REGISTERED LAND SURVEYOR 12028

DISTRIBUTION:

County Courthouse
Area Forester (Regions I & II)
District or Region Surveyor
Forestry Div., Lansing