


STATE OF MICHIGAN
DEPARTMENT
OF
NATURAL RESOURCES

LAND CORNER RECORD

MISSAUKEE COUNTY
T 24 N R 6 W

DESCRIPTION OF CORNER W 1/4 Corner, Section 2
CORNER MONUMENT Set DNR Monument
DATE MONUMENT PLACED AND WITNESSED 9-14-71
WITNESSES TO CORNER..... 16" B. Oak N 74 W 7.5'

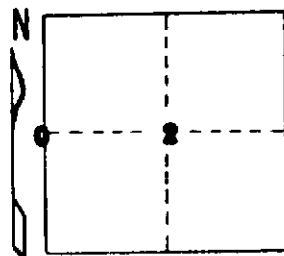


10" B. Oak N 63 E 68.1'
8" B. Oak S 65 E 29.7'
AND
N-S Random Due W 6.6'

CIRCLE CORNER REGISTERED

DESCRIPTION IN DETAIL AS TO HOW CORNER WAS LOCATED AND IDENTIFIED OR RESTORED.

No remaining U.S. evidence at this date.

Corner reestablished per B.L.M. instructions.

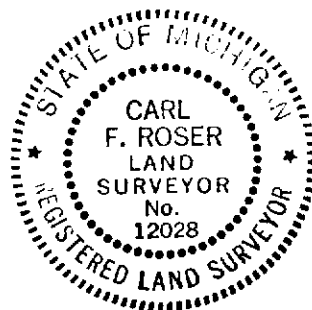

SURVEYOR'S SEAL

SIGNED Carl F. Roser DATE 9-21-71
REGISTERED LAND SURVEYOR 12028

DISTRIBUTION:

County Courthouse
Area Forester (Regions I & II)
District or Region Surveyor
Forestry Div., Lansing