

STATE OF MICHIGAN  
DEPARTMENT  
OF  
NATURAL RESOURCES

LAND CORNER RECORD


MISSAUKIE COUNTY  
T 24 N R 6 W

DESCRIPTION OF CORNER N 1/4 corner, Section 2

CORNER MONUMENT Set B&B Mon.

DATE MONUMENT PLACED AND WITNESSED 7-27-71

WITNESSES TO CORNER..... 14" W. Pine S 31 E 71.8'

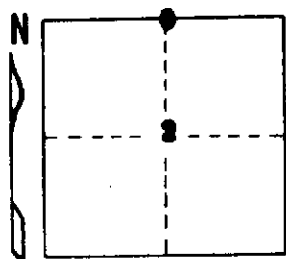

14" Oak S 52 W 46.7'

16" Oak N 22 E 38.6'


AND Ctr. E-W Trail Rd. Due N 3'

CIRCLE CORNER REGISTERED

DESCRIPTION IN DETAIL AS TO HOW CORNER WAS LOCATED AND IDENTIFIED OR RESTORED.

**No remaining U.S. evidence at this date.**

**Corner reestablished per B.L.N. instructions.**

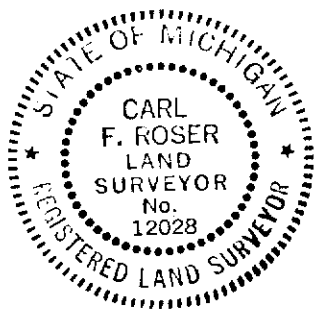

SURVEYOR'S SEAL

SIGNED Carl F. Roser DATE 8-3-71  
REGISTERED LAND SURVEYOR **12028**

DISTRIBUTION:

County Courthouse  
Area Forester (Regions I & II)  
District or Region Surveyor  
Forestry Div., Lansing

R 4047  
Rev. 10/68