


STATE OF MICHIGAN  
DEPARTMENT  
OF  
NATURAL RESOURCES  
LAND CORNER RECORD

MISSAUKEE COUNTY  
T 24 N R 6 W

DESCRIPTION OF CORNER E 1/4 corner, Section 6  
CORNER MONUMENT Set DNR Monument in Ctr. of N-S Co. dirt rd.  
DATE MONUMENT PLACED AND WITNESSED 8-12-71  
WITNESSES TO CORNER..... 7" Maple - 3-cluster S 58 E 99.2'

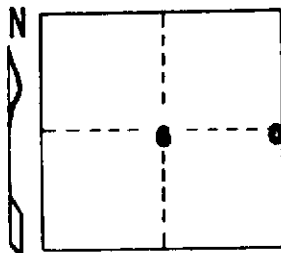


8" Maple - 3-cluster N 74 E 102.9'  
10" Oak S 56 W 79.4'  
AND

CIRCLE CORNER REGISTERED

DESCRIPTION IN DETAIL AS TO HOW CORNER WAS LOCATED AND IDENTIFIED OR RESTORED.

**No U.S. evidence at this date. Corner reestablished per BLM instructions.**

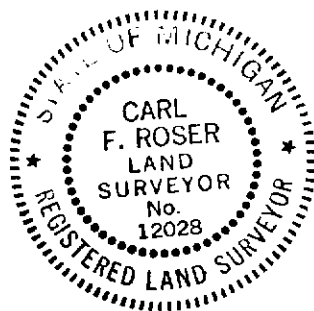

SURVEYOR'S SEAL

*Carl F. Roser*

SIGNED

REGISTERED LAND SURVEYOR

DATE

8-19-71

DISTRIBUTION:

County Courthouse  
Area Forester (Regions I & II)  
District or Region Surveyor  
Forestry Div., Lansing

12028

R 4047  
Rev. 10/68