

STATE OF MICHIGAN
DEPARTMENT
OF
NATURAL RESOURCES

LAND CORNER RECORD

MISSAUKEE COUNTY


T 24 N R 6 W

DESCRIPTION OF CORNER E. N. 1/4 Corner, Section 12 or
1/4 Section corner common to Secs. 12-7

CORNER MONUMENT Set DNR Monument & Square Cedar post.

DATE MONUMENT PLACED AND WITNESSED 7-26-71

WITNESSES TO CORNER..... 6" W. Pine N 40 W 54.4'

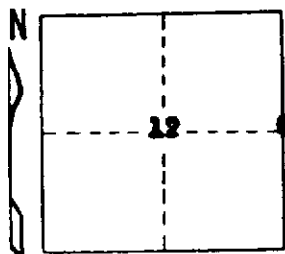

14" W. Pine N 61 E 44.0'


30" W. Pine N 11 W 48.5'

AND N-S Road Due W. 1.3'

CIRCLE CORNER REGISTERED

DESCRIPTION IN DETAIL AS TO HOW CORNER WAS LOCATED AND IDENTIFIED OR RESTORED.

Corner reestablished per Standard D.L.M. instructions.

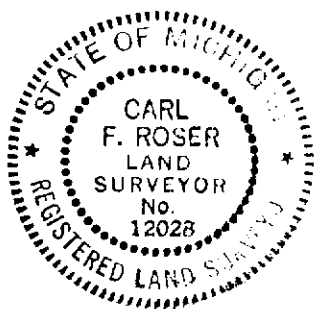

SURVEYOR'S SEAL

SIGNED Carl F. Roser DATE 8-2-71
REGISTERED LAND SURVEYOR 12028

DISTRIBUTION:

County Courthouse
Area Forester (Regions I & II)
District or Region Surveyor
Forestry Div., Lansing

R 4047
Rev. 10/68