


STATE OF MICHIGAN
DEPARTMENT
OF
NATURAL RESOURCES

LAND CORNER RECORD

MISSAUKEE COUNTY
T 24 N R 6 W

DESCRIPTION OF CORNER E 1/4 corner, Section 10
CORNER MONUMENT Set Std. Dept. Mon at Inter. of old Fm (cor. Post) N-S+E.
DATE MONUMENT PLACED AND WITNESSED 4-30-71

WITNESSES TO CORNER..... W. Pine Stump 24" N 54 E 24 L.
(stump still intact showing blaze & notch)

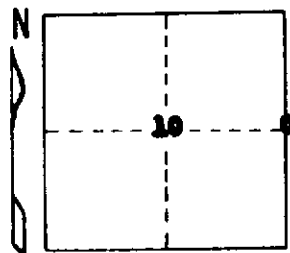

W. Pine Stump 30" S 30 W 11 L.
(stump partially gone)

18" E. Pine S 08 W 62.6'


AND

10" Maple in grp of 3 S 42 E 30.0'

CIRCLE CORNER REGISTERED N-S Random West 11'

DESCRIPTION IN DETAIL AS TO HOW CORNER WAS LOCATED AND IDENTIFIED OR RESTORED.

**Accepted corner fence post which fits two Wit. from 1887 survey of Section 10,
which is of record in old County Surveyor books at Missaukee County Road Comm.**

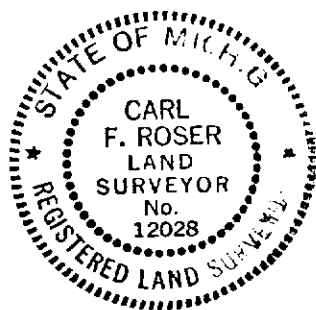

SURVEYOR'S SEAL

Carl F. Roser

SIGNED

REGISTERED LAND SURVEYOR

12028

DATE

5-7-71

DISTRIBUTION:

County Courthouse
Area Forester (Regions I & II)
District or Region Surveyor
Forestry Div., Lansing

R 4047
Rev. 10/68