


STATE OF MICHIGAN
DEPARTMENT
OF
NATURAL RESOURCES

LAND CORNER RECORD

MISSAUKEE COUNTY
T 24 N R 6 W

DESCRIPTION OF CORNER NE corner of Section 10
CORNER MONUMENT Set DNR Monument
DATE MONUMENT PLACED AND WITNESSED 8-16-71


WITNESSES TO CORNER.....	4" B. Cherry	S 07 W	14.2'
	12" W. Birch	N 64 W	28.6'
	6" Maple	N 33 W	9.3'
	AND N Edge of swamp	Due N	30'

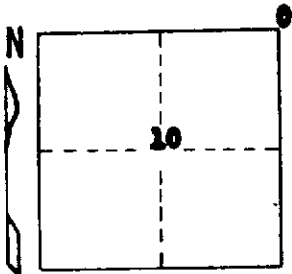

CIRCLE CORNER REGISTERED

DESCRIPTION IN DETAIL AS TO HOW CORNER WAS LOCATED AND IDENTIFIED OR RESTORED.

Restored corner on extension of line and double the distance of 1/4 corner and Section corner to South. Restoration by this method makes the center of Sec. 10 agree with the S 1/2 of the N-S 1/4 line as occupied (fences & rd). There is a record of the splitup of Sec. 10 in Old County Surveyors book at County Road Commission dated Oct. 1887. Corner as established fits U.S. swamp tie to South.

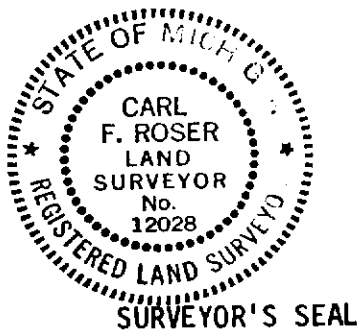

Carl F. Roser

SIGNED _____ DATE 8-23-71
REGISTERED LAND SURVEYOR 12028

DISTRIBUTION:

County Courthouse
Area Forester (Regions I & II)
District or Region Surveyor
Forestry Div., Lansing

R 4047
Rev. 10/68