

STATE OF MICHIGAN
DEPARTMENT
OF
NATURAL RESOURCES

LAND CORNER RECORD


MISSAUKEE COUNTY
T 24 N R 6 W

DESCRIPTION OF CORNER SW corner of Section 10

CORNER MONUMENT Found 1 1/2" pipe

DATE MONUMENT PLACED AND WITNESSED 7-26-71

WITNESSES TO CORNER..... P. Pole S 59 E 59.0'

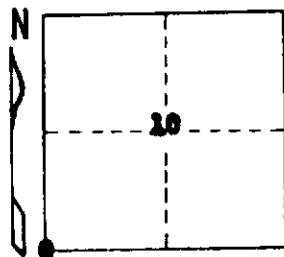

8" W. Pine S 41 W 61.69'


22" W. Pine N 62 W 110.80'

AND

CIRCLE CORNER REGISTERED

DESCRIPTION IN DETAIL AS TO HOW CORNER WAS LOCATED AND IDENTIFIED OR RESTORED.

Recovered 1 1/2" pipe for corner, in center of N-S County road and 9 ft. of E-W County Road.

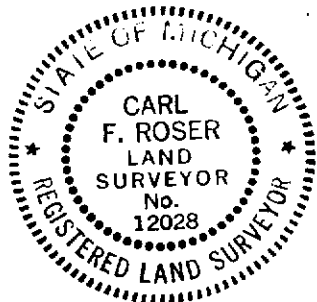

SURVEYOR'S SEAL

Carl F. Roser

SIGNED

REGISTERED LAND SURVEYOR

DATE

8-2-71

DISTRIBUTION:

12028

County Courthouse
Area Forester (Regions I & II)
District or Region Surveyor
Forestry Div., Lansing

R 4047
Rev. 10/68