


STATE OF MICHIGAN
DEPARTMENT
OF
NATURAL RESOURCES

LAND CORNER RECORD

MISSAUKIE COUNTY
T 24 N R 6 W

DESCRIPTION OF CORNER Ctr. of Section 10
CORNER MONUMENT Set 1"x30" pipe & cedar post
DATE MONUMENT PLACED AND WITNESSED 8-18-71
WITNESSES TO CORNER..... 20" W. Pine S 59 E 42.3'

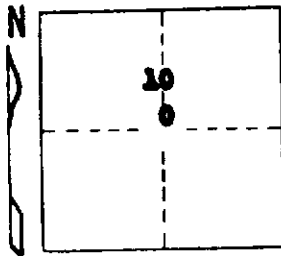


9" Cedar S 62 W 29.3'
9" Cedar N 87 W 21.7'
AND

CIRCLE CORNER REGISTERED

DESCRIPTION IN DETAIL AS TO HOW CORNER WAS LOCATED AND IDENTIFIED OR RESTORED.

Corner established per standard B.L.M. instructions. This fits average line of road and fences to S and old 1/16 corner a 1/4 mile to East. There is a record of the splitup of Sec. 10 in old County Surveyors book at County Road Commission dated Oct. 1887.

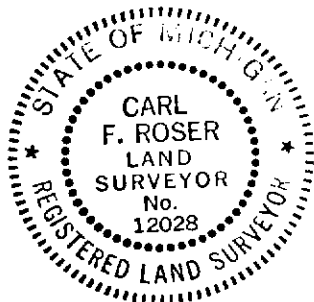

SURVEYOR'S SEAL

SIGNED

Carl F. Roser
REGISTERED LAND SURVEYOR 12028

DATE

8-20-71

DISTRIBUTION:

County Courthouse
Area Forester (Regions I & II)
District or Region Surveyor
Forestry Div., Lansing

R 4047
Rev. 10/68