


STATE OF MICHIGAN
DEPARTMENT
OF
NATURAL RESOURCES

LAND CORNER RECORD

MISSAUKEE COUNTY
T 24 N R 6 W

DESCRIPTION OF CORNER SE corner of Section 10
CORNER MONUMENT Set DNR Mon. by point of old stake.
DATE MONUMENT PLACED AND WITNESSED 7-26-71
WITNESSES TO CORNER..... P. Pole S 6 W 63.9'

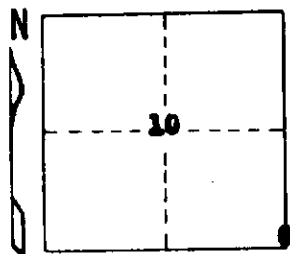


P. Pole N 50 W 54.4'
30" Maple N 61 E 52.29'
AND Fence cor. post S 4 W 39.3'
Fence cor. post N 3 E 31.6'

CIRCLE CORNER REGISTERED

DESCRIPTION IN DETAIL AS TO HOW CORNER WAS LOCATED AND IDENTIFIED OR RESTORED.

Found old painted stake bottom for corner in center of E-W County Road and in line with fence to N & S.

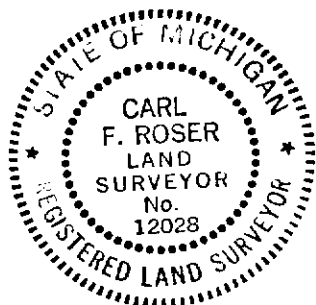

SURVEYOR'S SEAL

Carl F. Roser

SIGNED

REGISTERED LAND SURVEYOR 12028

DATE

8-2-71

DISTRIBUTION:

County Courthouse
Area Forester (Regions I & II)
District or Region Surveyor
Forestry Div., Lansing

R 4047
Rev. 10/68