

STATE OF MICHIGAN
DEPARTMENT
OF
NATURAL RESOURCES

LAND CORNER RECORD


MISSAUKIE COUNTY
T 24 N R 6 W

DESCRIPTION OF CORNER E 1/16 Cor. on N. line of Sec. 10

CORNER MONUMENT Set 1"x36" Pipe

DATE MONUMENT PLACED AND WITNESSED 12-18-71

WITNESSES TO CORNER..... 18" Oak S 68 W 39.1'

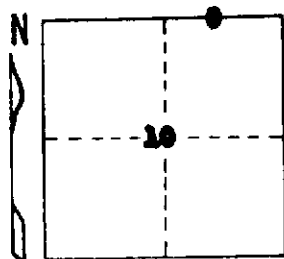

11" Oak S 66 E 20.1'


7" Oak N 40 W 61.8'

AND

CIRCLE CORNER REGISTERED

DESCRIPTION IN DETAIL AS TO HOW CORNER WAS LOCATED AND IDENTIFIED OR RESTORED.

Corner established per Standard B.L.M. instructions.

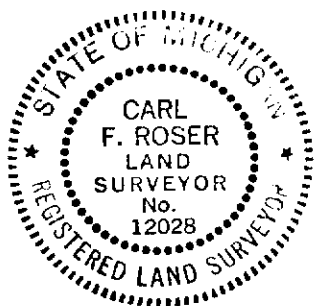

SURVEYOR'S SEAL

SIGNED Carl F. Roser DATE 12-28-71
REGISTERED LAND SURVEYOR **12028**

DISTRIBUTION:

County Courthouse
Area Forester (Regions I & II)
District or Region Surveyor
Forestry Div., Lansing