

STATE OF MICHIGAN
DEPARTMENT
OF
NATURAL RESOURCES

LAND CORNER RECORD


MISSAUKEE COUNTY
T 24 N R 6 W

DESCRIPTION OF CORNER South 1/4 corner, Sec. 9

CORNER MONUMENT Set DNR mon. in ctr. of E-W Co. Rd.

DATE MONUMENT PLACED AND WITNESSED 8-18-71

WITNESSES TO CORNER..... 5" Twin Hemlock S 18 W 37.3'

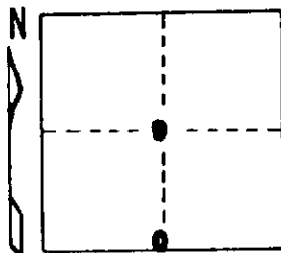

8" Maple S 46 E 58.8'


5" Maple N 45 E 35.3'

AND
Cor. Fa. Post North 31'

CIRCLE CORNER REGISTERED

DESCRIPTION IN DETAIL AS TO HOW CORNER WAS LOCATED AND IDENTIFIED OR RESTORED.

Corner reestablished on line between Sec. corners to E & W and in line with line fence to N., which is very close to the split of the mile.

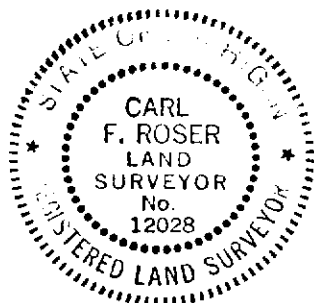

SURVEYOR'S SEAL

SIGNED Carl F. Roser DATE 8-20-71
REGISTERED LAND SURVEYOR 12028

DISTRIBUTION:

County Courthouse
Area Forester (Regions I & II)
District or Region Surveyor
Forestry Div., Lansing

R 4047
Rev. 10/68