

STATE OF MICHIGAN
DEPARTMENT
OF
NATURAL RESOURCES

LAND CORNER RECORD


MISSAUKEE COUNTY
T 24 N R 6 W

DESCRIPTION OF CORNER N 1/4 corner, Section 9

CORNER MONUMENT Set DNR Mon. by Sq. Cedar Post remains

DATE MONUMENT PLACED AND WITNESSED 7-29-71

WITNESSES TO CORNER..... 5" W. Pine N 20 E 37.4'

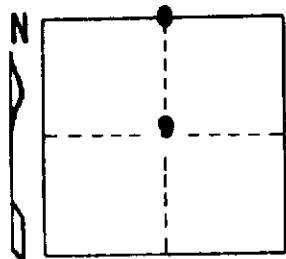

2 1/2" W. Pine stp. N 20 W 42.5'

2 1/2" W. Pine Stp. N 60 W 62.0'


AND

4" W. Pine S 6 E 47.4'

CIRCLE CORNER REGISTERED E-W Random Due S 40'

DESCRIPTION IN DETAIL AS TO HOW CORNER WAS LOCATED AND IDENTIFIED OR RESTORED.

Recovered corner (remains of Sq. Cedar Post) per 1909 Survey witness as noted in old Co. Surveyors Book at Co. Rd. Comm.

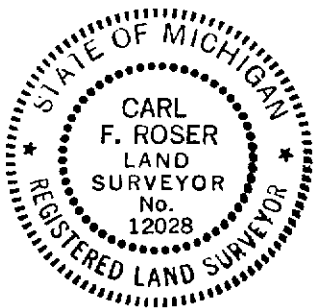

SURVEYOR'S SEAL

SIGNED Carl F. Roser DATE 8-5-71
REGISTERED LAND SURVEYOR 12028

DISTRIBUTION:

County Courthouse
Area Forester (Regions I & II)
District or Region Surveyor
Forestry Div., Lansing