


STATE OF MICHIGAN
DEPARTMENT
OF
NATURAL RESOURCES

LAND CORNER RECORD

MISSAUKEE COUNTY
T 24 N R 6 W

DESCRIPTION OF CORNER SW corner of Sec. 9
CORNER MONUMENT Fd 1 1/2" well point at intersection of Co. rds N-S-E-W.
DATE MONUMENT PLACED AND WITNESSED 7-26-71
WITNESSES TO CORNER..... P. Pole S 21 W 189.6'

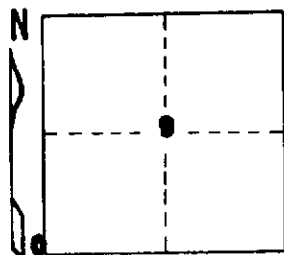


14" Walnut N 87 E 291.60'
8" Red Pine N 42 W 101.45'
AND _____

CIRCLE CORNER REGISTERED

DESCRIPTION IN DETAIL AS TO HOW CORNER WAS LOCATED AND IDENTIFIED OR RESTORED.

Recovered 1 1/2" well point that fits occupancy.

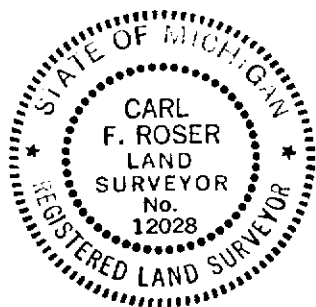

SURVEYOR'S SEAL

SIGNED Carl F. Roser DATE 8-2-71
REGISTERED LAND SURVEYOR 12028

DISTRIBUTION:

County Courthouse
Area Forester (Regions I & II)
District or Region Surveyor
Forestry Div., Lansing

R 4047
Rev. 10/68