

✓

STATE OF MICHIGAN
DEPARTMENT
OF
NATURAL RESOURCES

LAND CORNER RECORD


MISSAUKEE COUNTY
T 26 N R 6 W

DESCRIPTION OF CORNER E 1/4 corner, Section 9

CORNER MONUMENT Set DNR Monument

DATE MONUMENT PLACED AND WITNESSED 8-18-71

WITNESSES TO CORNER..... P. Pole S 84 E 29.94'

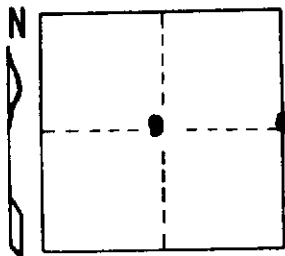

9" Maple S 72 W 39.21'


10" Maple S 43 W 54.78'

AND

CIRCLE CORNER REGISTERED

DESCRIPTION IN DETAIL AS TO HOW CORNER WAS LOCATED AND IDENTIFIED OR RESTORED.

Corner reestablished in center of N-S dirt County Road in line with line fence remains to East. This is very close to a computed position by proportion between section corners to N & S.

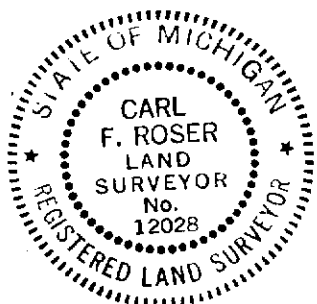

SURVEYOR'S SEAL

Carl F. Roser

SIGNED _____ DATE 8-20-71
REGISTERED LAND SURVEYOR **12028**

DISTRIBUTION:

County Courthouse
Area Forester (Regions I & II)
District or Region Surveyor
Forestry Div., Lansing

R 4047
Rev. 10/68