


STATE OF MICHIGAN
DEPARTMENT
OF
NATURAL RESOURCES

LAND CORNER RECORD

MISSAUKEE COUNTY
T 24 N R 6 W

DESCRIPTION OF CORNER Ctr. of Sec. 8
CORNER MONUMENT Set 1"x36" pipe & Cedar post w/location tag
DATE MONUMENT PLACED AND WITNESSED 9-20-71
WITNESSES TO CORNER..... 18" B. Cherry S 82 E 95.3'

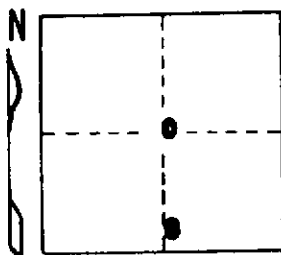


18" B. Cherry N 7 W 69.3'
Fen. remains S. Due E 13'
Fen. remains W Due S 5'
AND
Irregular Fen. remains N Due W 35'

CIRCLE CORNER REGISTERED

DESCRIPTION IN DETAIL AS TO HOW CORNER WAS LOCATED AND IDENTIFIED OR RESTORED.

Corner established per standard BLM instructions. Corner is in approximate center of old Twp Rd grade to East.

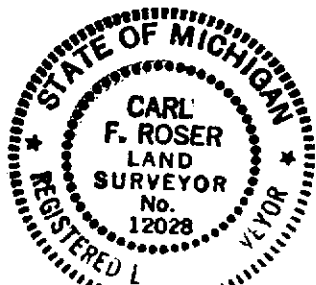

SURVEYOR'S SEAL

Carl F. Roser
SIGNED _____

DATE 9-27-71

DISTRIBUTION:

REGISTERED LAND SURVEYOR

12028

County Courthouse
Area Forester (Regions I & II)
District or Region Surveyor
Forestry Div., Lansing

R 4047
Rev. 10/68