


STATE OF MICHIGAN  
DEPARTMENT  
OF  
NATURAL RESOURCES

LAND CORNER RECORD

MISSAUKEE COUNTY  
T 24 N R 6 W

DESCRIPTION OF CORNER W 1/16 on E-W 1/4 line, Sec. 6  
CORNER MONUMENT Set 1"x36" pipe & Cedar Guard post with location tag  
DATE MONUMENT PLACED AND WITNESSED 9-21-71  
WITNESSES TO CORNER..... 6" Maple S 82 E 18.4'

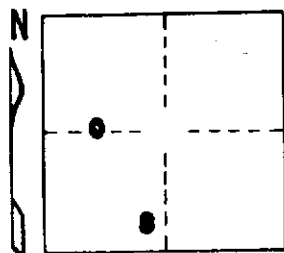


7" Maple N 85 W 10.5'  
5" Maple N 85 W 19.9'  
AND

CIRCLE CORNER REGISTERED

DESCRIPTION IN DETAIL AS TO HOW CORNER WAS LOCATED AND IDENTIFIED OR RESTORED.

Corner established per standard DIM instructions. Old corner fence post 3' N and 8' E.

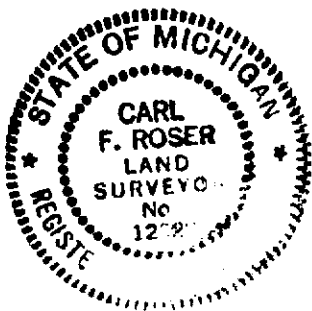

SURVEYOR'S SEAL

SIGNED Carl F. Roser DATE 9-28-71  
REGISTERED LAND SURVEYOR  
12028

DISTRIBUTION:

County Courthouse  
Area Forester (Regions I & II)  
District or Region Surveyor  
Forestry Div., Lansing

R 4047  
Rev. 10/68