

LAND CORNER RECORDATION CERTIFICATE
Filing Requirement of Act 74, Mich. P.A. 1970

For corners in
MISSAUKEE
 (County)

Located In: _____ Corner Code ##

- | | | | |
|------------------------------------|---|----------------|-------------------|
| 1. Public Land Survey | T | <u>24NR 6W</u> | <u>L-12, L-13</u> |
| | T | _____ | _____ |
| | T | _____ | _____ |
| | T | _____ | _____ |
| 2. Property Controlling in Section | S | <u>36</u> | <u>15</u> |
| | S | _____ | _____ |
| 3. Miscellaneous Property in Sec. | S | _____ | _____ |
| | S | _____ | _____ |
4. Lot No. _____, Recorded Plat _____
 5. Private Claims _____

Register of Deeds Stamp & File Number

I, CARL F. ROSER, in a field survey on AUGUST 28, 19 91, do hereby certify that under requirements of P.A. 74, Michigan P.A. of 1970, the corner points mentioned in lines 1 and 2 above were in conformance with regulations and rules therefore as required in the current manual of survey instructions of the United States Department of the Interior, Bureau of Land Management or by a decree of a Court of Law and/or that the corner points mentioned in lines 3, 4 and 5 above were in conformance with the rules of the Michigan Board of Land Surveyors or by a Decree of a Court of Law; established, re-established, monumented, re-monumented, recovered, found as expressed below:

NOTE: Not more than 4 corners, all in the same town and range, may be recorded on this certificate.

	A	B	C	D	E	F	G	H	I	J	K	L	M
2	6	5	4	3	2	1							
3													
4	7	8	9	10	11	12							
5													
6	18	17	16	15	14	13							
7													
8	19	20	21	22	23	24							
9													
10	30	29	28	27	26	25							
11													
12	31	32	33	34	35	36							
13													

A. Description of original monument and accessories and/or subsequent restoration:
 L-12 L-13 15

L-12
 RECOVERED 1/2" REROD FOR CTR SEC 36. RLS GEORGE D. HENNING, LS02240, SET THIS COR AT INTERSECTION OF QUARTER LINES IN 1967.

L-13
 RESTORED S 1/4 COR OF SEC 36 PER PRIOR SURVEYS OF RECORD BY RLS'S: GEO. HENNING (1967), GENE OSTLING (1968), AND LARRY CAVANAGH. COPIES OF THESE SURVEYS IN OUR SURVEY FILE. LINE OF NEWER CEDAR POSTS W/ 1 STRAND B-W, RUNNING W'LY IS 20' EAST. OLD E-W BARBWIRE FN IS 4' (±2') SOUTH.

15
 ESTABLISHED SE COR OF SW 1/4 OF SW 1/4 OF SEC 36 PER STANDARD BLM INSTRUCTIONS. COR IS IN LINE (±5') W/OLD FN REMAINS LOOKING TO N. OLD FN REMAINS TO E IS 7' SOUTH.


B. Description of corner evidence found and/or method applied in restoring or reestablishing corner:

C. Description of monument for corner and accessories established to perpetuate locating the position of the corner:

L-12
 FD 1/2" X 24" REROD, ADDED 1" X 48" GALV PIPE W/RLS CAP. SET CED POST.
 #8" X 6' CED STUB N50°W 15.4'
 6" CEDAR N25°W 20.12'
 6" CEDAR S40°E 12.87'
 #7" DEAD CEDAR S20°W 9.1'
 6" CEDAR S45°W 16.83

L-13
 SET DNR MON & CED POST.
 3" BALSAM N65°W 1.2'
 3" BEECH S35°E 6.0'
 13" SUGAR MAPLE SOUTH 30.0'
 8" SUGAR MAPLE S57°W 23.1'

15
 DROVE 5/8" X 34" REROD AND SET CED POST W/LOC TAG.
 8" SUG MAPL (CLP 2) N65°W 7.9'
 7" SUG MAPLE N15°W 3.2'
 6" TWIN BEECH S85°E 10.5'
 8" MAPLE S20°W 5.0'

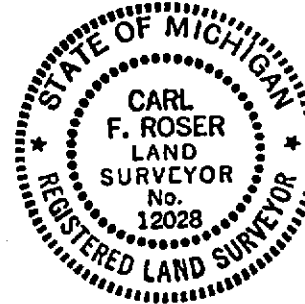

Signed by Carl F. Roser

Date 8-10-92

Surveyor's Michigan License No. 12028