LAND CORNER RECORDATION CERTIFICATE

Filing Requirement of Act 74, Mich. P.A. 1970

For corners in MISSAUKEE (County)

	Located In:	Corner Code ##
1. Public Land Survey	T 24N R 6W	E-3
	T ___ R ___	
	T ___ R ___	
	T ___ R ___	
2. Property Controlling	S 8 T ___ R ___	4,7
in Section	S ___ T ___ R ___	
3. Miscellaneous	S ___ T ___ R ___	
Property in Sec.	S ___ T ___ R ___	

Register of Deeds Stamp & File Number

4. Lot No. _____ , Recorded Plat _____
5. Private Claims _____

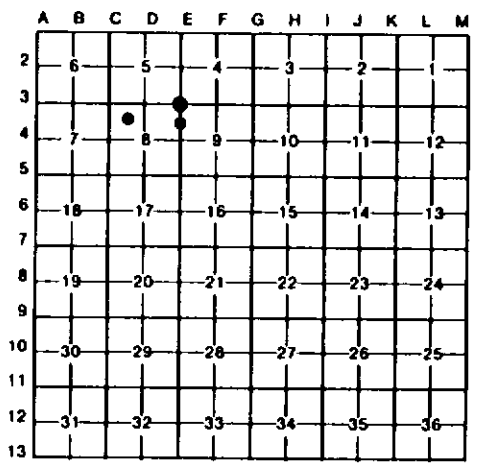

I, CARL T. KIISKILA, in a field survey on DEC. 20, 19 94, do hereby certify that under requirements of P.A. 74, Michigan P.A. of 1970, the corner points mentioned in lines 1 and 2 above were in conformance with regulations and rules therefore as required in the current manual of survey instructions of the United States Department of the Interior, Bureau of Land Management or by a decree of a Court of Law and/or that the corner points mentioned in lines 3, 4 and 5 above were in conformance with the rules of the Michigan Board of Land Surveyors or by a Decree of a Court of Law; established, re-established, monumented, re-monumented, recovered, found as expressed below:

NOTE: Not more than 4 corners, all in the same town and range, may be recorded on this certificate.

A. Description of original monument and accessories and/or subsequent restoration:

E-3
(NO EVIDENCE OF G.L.O. CORNER, B.T'S, LINE TREES & TOPOGRAPHY, AS CALLED OUT IN THE G.L.O. LINE NOTES; UNLESS NOTED IN ITEM "B" BELOW.)

4

7

B. Description of corner evidence found and/or method applied in restoring or reestablishing corner:

E-3
REESTABLISHED NE COR OF S-8 BY USING WITNESS TREES FOR COR ESTABLISHED BY C.F.ROSER IN 1971 DEPT. SURVEY. (C.F.ROSER REESTAB. COR ON AVERAGE LINE OF OLD TWP RD GRADE AND AVERAGE SPLIT OF ROW FN'S 1-MILE S, AT DOUBLE DIST OF S 1/2 MILE(±2'). THIS FITS FN W AT N 1/16 COR BETWEEN SEC'S 8 & 9).

4
FD. PIPE FOR CENTER OF NW 1/4 SECTION 8 AS ESTABLISHED IN 1971 DEPT. SURVEY AND RECORDED NEW WITNESS. OLD B/WIRE FENCE, E-W IS 53'±7' N AND OLD B/WIRE FENCE, N-S IS 114±8' W. CENTER OF CONSUMER POWER CO. GAS LINE OPENING TO NW IS 60'±5' E.

7
REESTABLISHED CORNER BY USING WITNESS TREES ESTABLISHED BY C.F. ROSER IN A 1971 DEPT. SURVEY (COR ESTAB. BY STANDARD BLM INSTRUCTIONS).

C. Description of monument for corner and accessories established to perpetuate locating the position of the corner:

E-3
SET DNR MON. & CEDAR POST.

#32" B. CHERRY	N07°E	35.3'
#18" B. CHERRY	S76°E	81.2'
#12"TRI B.CHERRY	S26°W	79.0'
12" R. PINE	N35°W	59.9'
CTR N-S DIRT RD	WEST	9'

#= C.F.ROSER,1971 WIT.

4
FD. 1" PIPE ADDED CEDAR POST WITH LOCATION TAG.

6" ASH	N 45°W	31.2'
8" ELM	N 05°E	34.3'
4"B.CHERRY-CLP	S 60°E	32.7'
3" R. OAK	S 15°W	24.4'

7
DROVE 1"x 36" PIPE.

#9" CEDAR	N83°E	66.2'
5" BALSAM	N35°W	60.5'
#6" CEDAR	S56°E	78.6'
5" BALSAM	S65°W	28.4'
# 4"APPLE	S74°W	27.9'
SET CEDAR POST W/LOC TAG	WEST	33'
CTR N-S DIRT RD	DUE E	1'

#= C.F.ROSER, 1971 WIT. [redacted]'

STATE OF MICHIGAN
CARL KIISKILA
LAND SURVEYOR
No. 33981
LICENSED LAND SURVEYOR

Signed by Carl T Kiiskila Date 1-10-95

Surveyor's Michigan License No. 33981

FORM APPROVED BY MICHIGAN STATE BOARD OF LAND SURVEYORS, JAN. 28, 1971
REVISED MAY 14, 1975
REVISED JAN., 1983