


**LAND CORNER RECORDATION CERTIFICATE**  
**Filing Requirement of Act 74, Mich. P.A. 1970**

For corners in

|   |                          |               |
|---|--------------------------|---------------|
| <u>Missaukee</u><br><small>(County)</small> | Located In:              | Corner Code # |
| 1. Public Land Survey                       | T <u>24N</u> R <u>6W</u> | <u>K - 3</u>  |
|   | T _____ R _____          | _____         |
|   | T _____ R _____          | _____         |
| 2. Property Controlling<br>in Section       | S _____ T _____ R _____  | _____         |
|   | S _____ T _____ R _____  | _____         |
| 3. Miscellaneous<br>Property in Sec.        | S _____ T _____ R _____  | _____         |
|   | S _____ T _____ R _____  | _____         |

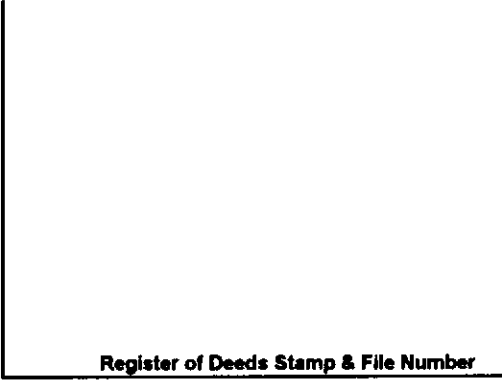

4. Lot No. \_\_\_\_\_, Recorded Plat \_\_\_\_\_

5. Private Claims \_\_\_\_\_

I, Craig W. McVean, in a field survey on MAY, 29 19 97  
do hereby state that under requirements of P.A. 74, Michigan P.A. of 1970, the  
corner points mentioned in lines 1 and 2 above were in conformance with  
regulations and rules therefore as required in the current manual of survey  
instructions of the United States Department of the Interior, Bureau of Land  
Management or by a decree of a Court of Law and /or that the corner points  
mentioned in lines 3, 4 and 5 above were in conformance with the rules of the  
Michigan Board of Land Surveyors or by a Decree of a Court of Law; established,  
re-established, monumented, recovered, found as expressed below:

|    |    |    |    |    |    |    |   |   |   |   |   |   |
|----|----|----|----|----|----|----|---|---|---|---|---|---|
| A  | B  | C  | D  | E  | F  | G  | H | I | J | K | L | M |
| 1  |    |    |    |    |    |    |   |   |   |   |   |   |
| 2  | 6  | 5  | 4  | 3  | 2  | 1  |   |   |   |   |   |   |
| 3  |    |    |    |    |    |    |   |   |   |   |   |   |
| 4  | 7  | 8  | 9  | 10 | 11 | 12 |   |   |   |   |   |   |
| 5  |    |    |    |    |    |    |   |   |   |   |   |   |
| 6  | 18 | 17 | 16 | 15 | 14 | 13 |   |   |   |   |   |   |
| 7  |    |    |    |    |    |    |   |   |   |   |   |   |
| 8  | 19 | 20 | 21 | 22 | 23 | 24 |   |   |   |   |   |   |
| 9  |    |    |    |    |    |    |   |   |   |   |   |   |
| 10 | 30 | 29 | 28 | 27 | 26 | 25 |   |   |   |   |   |   |
| 11 |    |    |    |    |    |    |   |   |   |   |   |   |
| 12 | 31 | 32 | 33 | 34 | 35 | 36 |   |   |   |   |   |   |
| 13 |    |    |    |    |    |    |   |   |   |   |   |   |

**NOTE:** Not more than 2 corners, all in the same town and range, may be recorded on this certificate.

**A. Description of original monument and accessories and/or subsequent restoration:**

K-3 - GLO - Set Post - T. Whetpley - 1853 Resurvey  
Spruce 10" N75°W 25L  
Spruce 8" N73.5°E 22L  
Balsam 10" S43.5°E 17L.  
- Land Corner Record - From DNR Office - C.F. Roser - 8/23/71  
Re-established corner per standard BLM instructions (double proportion for one mile N, S, E, & W). There is something  
erroneous with U.S. stream and swamp ties in the immediate vicinity of this corner. Set Std. DNR Monument & small 3" Cedar  
Post.  
18" R. Pine S54°W 20.4'  
5" R. Pine S52°E 35.0'  
5" Balsam N31°W 17.3'  
Ctr. Stream Due West 54' ±  
Ctr. Stream Due South 243' ±  
N-S Random Due West 41'

**B. Description of corner evidence found and/or method applied in restoring or reestablishing corner:**

K-3 - Sec. cor. common to Sec. 1,2,11 & 12-Reset D.N.R. Monument position from 2 record BT's. 1971 Monument of C.F. Roser gone,  
did find cut off 3" Cedar post just north of reset position. Stream since dammed by beaver. Edge of beaver pond is North 7'  
and West 17'. Monument accepted as a careful and faithful re-establishment of the position of the original corner.

**C. Description of monument for corner and accessories established to perpetuate locating the position of the corner:**

K-3 - Set 4" DNR A.C. on 1" x 5" galvanized Iron Pipe. Set blue carsonite post 1' SE.  
\* 18" Dead Red Pine S50°W 20.4' to Notch in base blaze scribed "NBT"  
\* 14" Red Pine (w/ healed blaze) S55°E 35.31' to set nail and tag in NE side  
\* 7" Red Oak N50°E 55.74' to set nail and tag in N side  
\* 5" Balsam Fir N78°E 9.90' to set nail and tag in N side  
\* 10" Red Pine S15°E 72.58' to set nail and tag in E side  
\* = C.F. Roser 1971 DNR witness  
\* \* = Scribed "XBT"



Signed by Craig W. McVean  
Surveyor's Michigan License No. 39088

Date 8/26/1997