

MICHIGAN  
DEPARTMENT OF CONSERVATION  
FORESTRY DIVISION

LAND CORNER RECORD

T. 24 N.R. 7 W


Missaukee COUNTY

DESCRIPTION OF CORNER 1/4 corner common to Sections 2 - 11

CORNER MONUMENT Set 1" pipe with 4" aluminum cap

DATE MONUMENT PLACED AND WITNESSED June 29, 1966

WITNESSES TO CORNER.....

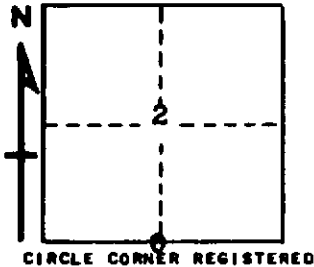

10" R. Oak N 28 E 27.6'

16" R. Oak N 88 W 43.5'

AND

DESCRIPTION IN DETAIL AS TO HOW CORNER WAS LOCATED AND IDENTIFIED OR RESTORED.

This corner was set by proportionate measurement between section corners. Could not locate anything for previous corner or USBTs.

SURVEYOR'S SEAL

SIGNED Kenneth Ostling DATE July 1, 1966  
REGISTERED LAND SURVEYOR #10068