

MICHIGAN  
DEPARTMENT OF CONSERVATION  
FORESTRY DIVISION

# LAND CORNER RECORD

T. 24 N.R. 7 W


Missaukee COUNTY

DESCRIPTION OF CORNER Sec. corner common to Sections 3-4-9-10

CORNER MONUMENT Set 1" pipe with 4" aluminum cap

DATE MONUMENT PLACED AND WITNESSED June 29, 1966

WITNESSES TO CORNER.....

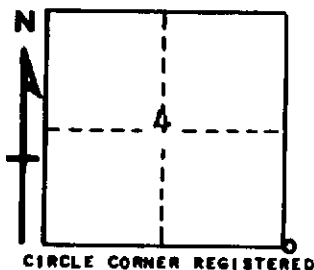

9" R. Oak N 8 W 42.6'

10" R. Oak N 85 E 16.2'

AND

DESCRIPTION IN DETAIL AS TO HOW CORNER WAS LOCATED AND IDENTIFIED OR RESTORED.

This corner was found while making a retracement in this township. Found 1 1/2" pipe in concrete cylinder at corner, as established in early survey by county surveyor. Unable to identify anything for USBTs, but checks good all directions for measurement. Buried monument with our corner.

SURVEYOR'S SEAL

SIGNED *Linneth Ostlund* DATE July 1, 1966  
REGISTERED LAND SURVEYOR #10068