

MICHIGAN
DEPARTMENT OF CONSERVATION
FORESTRY DIVISION

LAND CORNER RECORD

T. 24 N.R. 7 W


Missaukee COUNTY

DESCRIPTION OF CORNER 1/4 corner common to Sections 8 and 17

CORNER MONUMENT Set 1" pipe with 1/4" Aluminum cap

DATE MONUMENT PLACED AND WITNESSED June 14, 1966

WITNESSES TO CORNER.....

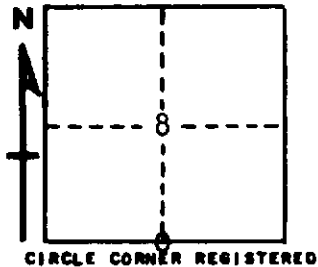

CIRCLE CORNER REGISTERED

2 1/4" W. Pine stump N 79 E 12.1'

Twin 7" Maple N 68 W 76.0'

AND

DESCRIPTION IN DETAIL AS TO HOW CORNER WAS LOCATED AND IDENTIFIED OR RESTORED.

This corner was found while making a retracement in this township. Found pipe in concrete monument at corner as established in early county survey. Fits good for line and measurement between section corners. Nothing left for USBTs.

SURVEYOR'S SEAL

SIGNED Kenneth J. Ostling DATE June 14, 1966
REGISTERED LAND SURVEYOR #10068