

MICHIGAN
DEPARTMENT OF CONSERVATION
FORESTRY DIVISION

LAND CORNER RECORD

T. 24 N. R. 7 W


Missaukee COUNTY

DESCRIPTION OF CORNER Sec. corner common to Sections 7-8-17-18

CORNER MONUMENT Set 1" pipe with 4" aluminum cap.

DATE MONUMENT PLACED AND WITNESSED June 14, 1966

WITNESSES TO CORNER.....

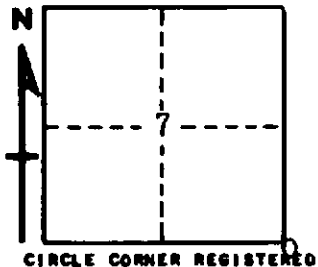

10" R. Oak S 59 W 53.2'

9" R. Oak N 45 W 11.7'

AND

DESCRIPTION IN DETAIL AS TO HOW CORNER WAS LOCATED AND IDENTIFIED OR RESTORED.

This corner was found while making a survey in this township. Found pipe in concrete monument at corner, probably as established in early survey by county surveyor. Fits very good for proportionate measurement and one probable USBT stump in place SE. Buried monument with our corner.

SURVEYOR'S SEAL

SIGNED *Kenneth J. Ostling* DATE June 15, 1966
REGISTERED LAND SURVEYOR #10068