

✓

MICHIGAN
DEPARTMENT OF CONSERVATION
FORESTRY DIVISION

LAND CORNER RECORD

T. 24 N.R. 7 W


Missaukee COUNTY

DESCRIPTION OF CORNER 1/4 corner common to Sections 1 - 12

CORNER MONUMENT Set 1" pipe with 4" Aluminum cap

DATE MONUMENT PLACED AND WITNESSED July 20, 1966

WITNESSES TO CORNER.....

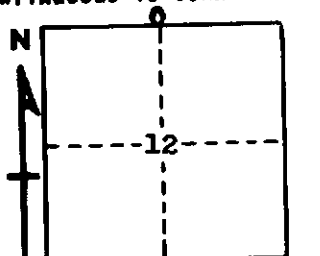

12" H. Maple N 10 E 11.9'

9" H. Maple S 78 E 35.4'

AND

CIRCLE CORNER REGISTERED

DESCRIPTION IN DETAIL AS TO HOW CORNER WAS LOCATED AND IDENTIFIED OR RESTORED.

This corner was set by proportionate measurement, midpoint on line, between section corner. No other evidence.

SURVEYOR'S SEAL

SIGNED Kenneth Osling DATE August 10, 1966
REGISTERED LAND SURVEYOR #10068