LAND CORNER RECORDATION CERTIFICATE

Filing Requirement of Act 74, Mich. P.A. 1970

For corners in
MISSAUKEE
(County)

	Located in:	Corner Code =##
1. Public Land Survey	T 24N R 7W	C-3
	T ___ R ___	
	T ___ R ___	
	T ___ R ___	
2. Property Controlling	S 7 T ___ R ___	2
in Section	S ___ T ___ R ___	
3. Miscellaneous	S 7 T ___ R ___	4 666' S.
Property in Sec.	S ___ T ___ R ___	of COR-2

Register of Deeds Stamp & File Number

4. Lot No. _____ , Recorded Plat _____
5. Private Claims _____

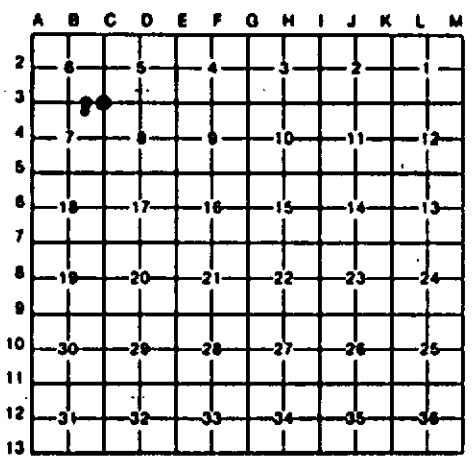

I, C.F.ROSER, in a field survey on OCT. 21, 19 92, do hereby certify that under requirements of P.A. 74, Michigan P.A. of 1970, the corner points mentioned in lines 1 and 2 above were in conformance with regulations and rules therefore as required in the current manual of survey instructions of the United States Department of the Interior, Bureau of Land Management or by a decree of a Court of Law and/or that the corner points mentioned in lines 3, 4 and 5 above were in conformance with the rules of the Michigan Board of Land Surveyors or by a Decree of a Court of Law; established, re-established, monumented, re-monumented, recovered, found as expressed below:

NOTE: Not more than 4 corners, all in the same town and range, may be recorded on this certificate.

A. Description of original monument and accessories and/or subsequent restoration:

C-3

2

4

B. Description of corner evidence found and/or method applied in restoring or reestablishing corner:

C-3
FD DEPT MON FOR NE COR OF SEC 7 AS SET BY RLS, K.OSTLING IN 1966 DEPT SURVEY (KJO SET COR SINGLE PROPORTION BETWEEN GOOD CORS 1/2 MILE SOUTH AND ONE MILE NORTH).

2
FD J.WILCOX IRON FOR NE COR OF NW1/4 OF NE1/4 OF SEC 7 (J.WILCOX 1974 SURVEY #74177).

4
FD J.WILCOX IRON FOR NW COR OF S1/2 OF NE1/4 OF NE1/4 COR OF SEC 7.(J.WILCOX 1974 SURVEY #74177). E-W TRAIL IS 126' N.

C. Description of monument for corner and accessories established to perpetuate locating the position of the corner:

C-3
FD DEPT MON & STEEL FN POST, SET CEDAR POST.

6"W.PINE	N06°W	34.5'
#18"OAK	N54°E	59.5'
5"R.PINE	N88°E	48.0'
3"MAPLE	S44°E	19.1'
#21"OAK	S72°W	52.0'

2
FD 1/2" REROD W/LS CAP & STUDDED STEEL FN POST. ADDED CEDAR POST W/LOC TAG.

6"R.PINE	N25°W	22.2'
11"R.OAK	S65°E	24.7'
3"R.PINE	S10°E	22.4'
8"MAPLE(CLP)	S75°W	20.3'

4
FD 1/2" REROD W/LS CAP & STUDDED STEEL FN POST. ADDED CEDAR POST W/LOC TAG.

11"R.OAK	N25°W	27.4'
3"R.OAK	N25°E	17.0'
6"S.MAPLE	S15°E	17.6'
11"MAPLE	S40°W	20.0'

STATE OF MICHIGAN
CARL F. ROSER
LAND SURVEYOR
No. 12028
REGISTERED LAND SURVEYOR

#= KJO 1966 WIT.

Signed by Carl F. Roser Date 4-27-94

Surveyor's Michigan License No. 12028

FORM APPROVED BY MICHIGAN STATE BOARD OF LAND SURVEYORS, JAN. 28, 1971
REVISED MAY 14, 1975
REVISED JAN., 1983