

LAND CORNER RECORDATION CERTIFICATE
Filing Requirement of Act 74, Mich. P.A. 1970

For corners in
MISSAUGUEE
 (County)

Located In: _____ Corner Code ≠#

- | | | | | | |
|------------------------------------|---|------------|---|------------|-----------------|
| 1. Public Land Survey | T | <u>24N</u> | R | <u>07W</u> | <u>E-6, M-5</u> |
| | T | _____ | R | _____ | _____ |
| | T | _____ | R | _____ | _____ |
| | T | _____ | R | _____ | _____ |
| 2. Property Controlling in Section | S | _____ | T | _____ | R |
| | S | _____ | T | _____ | R |
| 3. Miscellaneous Property in Sec. | S | _____ | T | _____ | R |
| | S | _____ | T | _____ | R |

Register of Deeds Stamp & File Number

4. Lot No. _____, Recorded Plat _____
 5. Private Claims _____

I, CARL T. KIISKILA, in a field survey on JUNE 4, 19 96, do hereby certify that under requirements of P.A. 74, Michigan P.A. of 1970, the corner points mentioned in lines 1 and 2 above were in conformance with regulations and rules therefore as required in the current manual of survey instructions of the United States Department of the Interior, Bureau of Land Management or by a decree of a Court of Law and/or that the corner points mentioned in lines 3, 4 and 5 above were in conformance with the rules of the Michigan Board of Land Surveyors or by a Decree of a Court of Law; established, re-established, monumented, re-monumented, recovered, found as expressed below:

NOTE: Not more than 4 corners, all in the same town and range, may be recorded on this certificate.

A	B	C	D	E	F	G	H	I	J	K	L	M
2	6	5	4	3	2	1						
3												
4	7	8	9	10	11	12						
5												
6	18	17	16	15	14	13						
7												
8	19	20	21	22	23	24						
9												
10	30	29	28	27	26	25						
11												
12	31	32	33	34	35	36						
13												

A. Description of original monument and accessories and/or subsequent restoration:

- | | | |
|--|--|--|
| E-6 | M-5 | |
| B. CONT.-- IN 1966 K.OSTLING RESTORED CORNER "AT A POINT ON LINE WITH 1/8 AND 1/4 CORNERS NORTH, MAKING THE 1/4 MILES OF EQUAL LENGTH. THIS PLACES THE COR AT POSITION INDICATED BY LOCAL RESIDENT OF NE-NE S-13, WHO SAW IT AT THIS POSITION BEFORE IT WAS --CONT. TO RIGHT | B. CONT.-- EXCAVATED DURING PIPELINE CONSTRUCTION. APPEARS TO HAVE BEEN ACCEPTED BY LOCAL OCCUPATION AND PREVIOUS SURVEYS. BEST AVAILABLE EVIDENCE". COR OF OLD WOVEN WIRE FN E-W-S ON CEDAR POSTS IS 33' SOUTH. CTR OLD E-W OVER GROWN TRAIL IS 3' SOUTH. | |


B. Description of corner evidence found and/or method applied in restoring or reestablishing corner:

- | | |
|--|--|
| E-6 | M-5 |
| SET DNR MON FOR E1/4 COR SEC. 17. CORNER RESET FROM MSHD 1967 WITS. AND P.S., C.F.ROSER 1981 WITS. IN 1981 DEPT. SURVEY C.ROSER ACCEPTED FD COUNTY SURVEYOR J.G.CAVANAGH CONC. MON. AS SET IN 1909, CONC MON HAS SINCE BEEN DESTROYED. COR IS 1' EAST OF CTR OLD UNUSED N-S GRADE. | FD DNR MON FOR NE COR S-13. IN 1990 DNR FOREST TECH. RESET MISSING DNR MON FROM FD ALL THREE 1971 C.F.ROSER WIT STPS. IN MAY 1996 WE FD 1966 WIT STPS OF RLS K.OSTLING AND 1971 PS C.F.ROSER WIT STPS THAT FIT DNR MON VERY GOOD, AND REWITS CORNER. CTR E-W SAND ROAD IS 35' NORTH. CTR TRAIL N'LY (LOOKING TO N.) IS 18'+/- 3' EAST. -- CONT. ABOVE -- |

C. Description of monument for corner and accessories established to perpetuate locating the position of the corner:

- | | |
|--|--|
| E-6 | M-5 |
| SET DNR MON & RESET CEDAR POST W/LOCATION TAG. | FD. DNR MON, ADDED CARSONITE POST. |
| *#10" SUG.MAPLE N32°W 17.75' | 4" TW.SUG.MAPLE N50°W 17.9' |
| #6" SUG.MAPLE N61°E 37.2' | 4" ELM EAST 20.0' |
| *#14" ASH S83°E 15.52' | 5" ASH S40°E 14.8' |
| 8" ASH S40°W 24.97' | 6" SUG.MAPLE S35°W 18.2' |
| 6" SUG.MAPLE S70°W 24.30' | FOUND 1/2"x 12" REROD WITH GEOPHYSICAL SYSTEMS ALUMN. CAP "H-4, 10, L-54" S24°W 12.98' |

*= MSHD WIT.
 #= C.F.ROSER 1981 WIT.

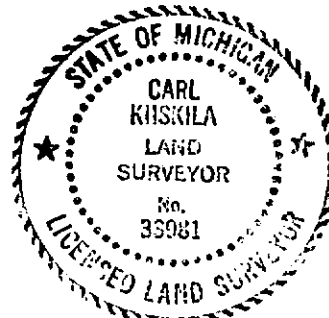

Signed by Carl T Kiiskila Date 7-9-96

Surveyor's Michigan License No. 33981