

LAND CORNER RECORDATION CERTIFICATE

Filing Requirement of Act 74, Mich. PA 1970

For Corners In: Missaukee Located In _____ Corner Code # _____
 (County)

1. Public Land Survey T 24N R 7W C6
 T _____ R _____ _____

2. Property Controlling in Section S _____ T _____ R _____
 S _____ T _____ R _____

3. Miscellaneous Property in Section S _____ T _____ R _____
 S _____ T _____ R _____


4. Lot No: _____ Recorded Plat: _____

5. Private Claims: _____

I, Craig W. McVean, in a field survey on April 18, 2005 do hereby state that under requirements of PA 74, Michigan PA of 1970, the corner points mentioned in lines 1 and 2 above were in conformance with regulations and rules therefore as required in the current manual of survey instructions of the United States Department of the Interior, Bureau of Land Management or by a decree of a Court of Law and/or that the corner points mentioned in lines 3, 4 and 5 above were in conformance with the rules of the Michigan Board of Land Surveyors or by a Decree of a Court of Law; established, re-established, monumented, recovered, found as expressed below:

NOTE: Not more than 2 corners, all in the same town and range, may be recorded on this certificate.

Register of Deeds Stamp & File Number

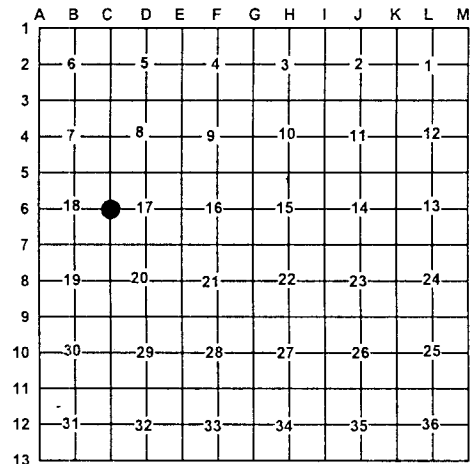

A. Description of original monument and accessories and/or subsequent restoration:

- C6 – GLO – Thomas Whelpley – 1852
 - Set post
 - Beech 5" N63 ½°W 2 links
 - Hemlock 6" S38 ½°E 12 links
- CSR – J. G. Cavanagh – Set gas pipe in concrete
 - W. Pine 36" N64°E 29 ½ links
 - Beech 6" S64°E 40 ½ links
- MSHD (MDOT) – J. L. Wilcox – 1967 – fd. 1" pipe in concrete monument 6" below surface of ground from old stump witnesses.
 - S72°W 44.53' 18" Oak; N75°E 32.21' 20" Maple
 - S02°E 67.85' 24" Twin Oak; N07°W 40.92' 18" Twin Maple

B. Description of corner evidence found and/or method applied in restoring or re-establishing corner:

C6 – Section ¼ Corner common to sections 17 & 18, T24N, R7W. Found 1" iron pipe in concrete per Cavanagh based upon 3 found witnesses of J. L. Wilcox. Also fd. evidence of J. G. Cavanagh W. Pine stump at N59°E 20.5'± to centerline of stump remains. E-W 2-track is 170'± S. 1" iron pipe is accepted as the best available evidence of the position of the original corner.

C. Description of monument for corner and accessories established to perpetuate locating the position of the corner:

C6 – Replaced 1" x 16" iron pipe in concrete cylinder with 4" Aluminum stamped DNR cap on 1" x 36" galv. iron pipe. Placed broken pieces of concrete mon. at bottom of mon. as memorial. Add ring of stone.

- N66°E 32.25' to set N & T in SE side 12" triple Maple (JLW)
- S06°E 68.14' to set N & T in W. side 18" twin Oak (JLW)
- S66°W 44.55' to set N & T in S. side 23" Oak (JLW)
- N08°E 10.96' to set N & T in W. side 12" Maple

