

✓

MICHIGAN
DEPARTMENT OF CONSERVATION
FORESTRY DIVISION

LAND CORNER RECORD

T. 24N N.R. 8 W


Missaukee COUNTY

DESCRIPTION OF CORNER Section corner common to Sections 10-11-14-15

CORNER MONUMENT Set 1" pipe with 4" aluminum cap

DATE MONUMENT PLACED AND WITNESSED 6-27-67

WITNESSES TO CORNER..... _____

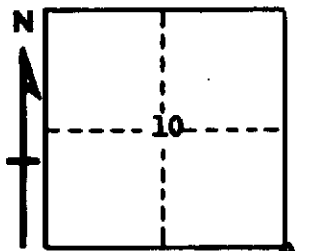

20" R. Oak S 50 E 33.5°

20" R. Pine Stp S 19 W 26.8°

AND _____

CIRCLE CORNER REGISTERED

DESCRIPTION IN DETAIL AS TO HOW CORNER WAS LOCATED AND IDENTIFIED OR RESTORED.

This corner was restored during a retracement in this township. Found Fargo pipe at corner, as established in 1912 survey for Consumers Power Company. Fargo record claims to have found scribed stake and U.S. witnesses and we check distance to corners west and north. This position results in a disproportionate subdivision of Sections 10-11-14, but cannot ignore Fargo record claiming U.S. evidence.

SURVEYOR'S SEAL

SIGNED *Kenneth J. Petting* DATE 6-29-67
REGISTERED LAND SURVEYOR #10068