

MICHIGAN
DEPARTMENT OF CONSERVATION
FORESTRY DIVISION

LAND CORNER RECORD

T. 24 N.R. 8 W


Missaukee COUNTY

DESCRIPTION OF CORNER Section corner common to Sections 20-21-28-29

CORNER MONUMENT Set 1" pipe with 4" aluminum cap

DATE MONUMENT PLACED AND WITNESSED 5-25-67

WITNESSES TO CORNER.....

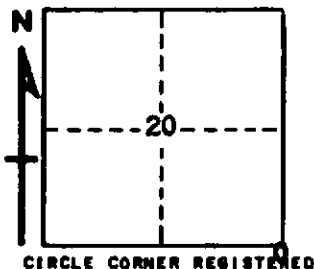

6" W. Pine S 75 W 44.0°

AND

DESCRIPTION IN DETAIL AS TO HOW CORNER WAS LOCATED AND IDENTIFIED OR RESTORED.

This corner was restored during a survey in this area. Found 1" pipe at fence corner as established in previous survey by unknown surveyor. Corner supported by SE USBT stump, in place, with partial face. Very good original corner.

SURVEYOR'S SEAL

SIGNED *Kenneth J. Ostling* DATE 6-15-67
REGISTERED LAND SURVEYOR 10068