

MICHIGAN  
DEPARTMENT OF CONSERVATION  
FORESTRY DIVISION

LAND CORNER RECORD

T. 24 N.R. 8 W


Missaukee COUNTY

DESCRIPTION OF CORNER Sec. corner common to Sections 9-10-15-16

CORNER MONUMENT Set 1" pipe with 4" alum. cap

DATE MONUMENT PLACED AND WITNESSED 4-17-67

WITNESSES TO CORNER.....

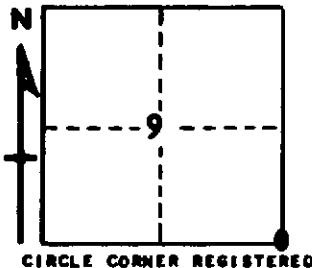

7" W. Oak N 30 E 35.2'

8" W. Oak S 55 E 55.6'

AND

DESCRIPTION IN DETAIL AS TO HOW CORNER WAS LOCATED AND IDENTIFIED OR RESTORED.

This corner was found during a retracement in this area. Found Fargo corner as established in 1912 survey for Consumers Power. Fargo record states corner was restored from U.S.B.T.s.

SURVEYOR'S SEAL

SIGNED \_\_\_\_\_ DATE 5-24-67

REGISTERED LAND SURVEYOR #10068