

LAND CORNER RECORDATION CERTIFICATE

Filing Requirement of Act 74, Mich. PA 1970

For Corners In: _____ Located In _____ Corner Code # _____
 Missaukee (County)

1. Public Land Survey	T	<u>24N</u>	R	<u>8W</u>	<u>I-3</u>
	T	_____	R	_____	_____
2. Property Controlling in Section	S	_____	T	R	_____
	S	_____	T	R	_____
3. Miscellaneous Property in Section	S	_____	T	R	_____
	S	_____	T	R	_____


4. Lot No: _____ Recorded Plat: _____

5. Private Claims: _____

I, Craig W. McVean, in a field survey on April 7, 2004 do hereby state that under requirements of PA 74, Michigan PA of 1970, the corner points mentioned in lines 1 and 2 above were in conformance with regulations and rules therefore as required in the current manual of survey instructions of the United States Department of the Interior, Bureau of Land Management or by a decree of a Court of Law and/or that the corner points mentioned in lines 3, 4 and 5 above were in conformance with the rules of the Michigan Board of Land Surveyors or by a Decree of a Court of Law; established, re-established, monumented, recovered, found as expressed below:

NOTE: Not more than 2 corners, all in the same town and range, may be recorded on this certificate.

Register of Deeds Stamp & File Number

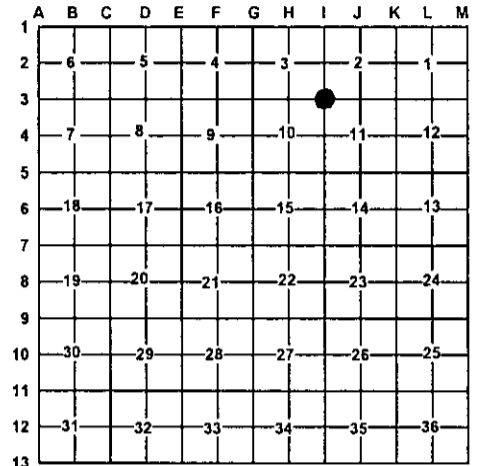

A. Description of original monument and accessories and/or subsequent restoration:

<p><u>I-3</u> – GLO – Set Post – T. Whelpley – 1853 Nor. Pine 10" N18°E 13 L. Nor. Pine 14" S33½°E 46 L. Nor. Pine 12" N31°W 19 L. - Fargo Eng. – 1912 – Fd. 3 US Wit. Set iron and crockery mon. NP Stp. 16" N38¾°E 64½ L. WPS 18" S52½°W 113 L. WPS 30" S45½°E 178¾ L.</p>	<p>- DNR Cor. Rec. and LCRC #335 – K. J. Ostling – 1967 Fd. old squared stk. At corner and Fargo Wit's. Supporting position. Set 1" pipe w/ 4" Alum. Cap.; 8" R. Oak Clp. N87°E 69.3'; 10" W. Oak S65°W 66.4'</p>
--	--

B. Description of corner evidence found and/or method applied in restoring or re-establishing corner:

I-3 – Sec. Cor. common to Sec. 2, 3, 10 & 11 – Fd. 4" DOC (DNR) Alum. Cap on 1" iron pipe per Ostling. GLO Wit's are gone. Fits the remains of Fargo's SW & SE BT's and the remains of Ostling SW BT. Fd. Ostling NE BT but distance short by 6'. N-S Powerline is W. 19.5'. DOC Mon. accepted as a careful and faithful perpetuation of the position of the original corner.

C. Description of monument for corner and accessories established to perpetuate locating the position of the corner:

I-3 – 4" DOC (DNR) Alum. Cap on 1" iron pipe w/ fd. cedar post on NNW side
 Set blue carsonite post 1' S.
 N85°E 63.24' to set N & T in N. side 10" and 2-20" R. Oak Clp. – 3 (KJO)
 S18°W 21.72' to set N & T in W. side 6" R. Pine
 N87°W 19.81' to set N & T in N. side PP
 N40°E 41.01' to set N & T in NW side 7" R. Maple Clp. – 3
 N52°W 53.07' to set N & T in NE side 8" R. Pine scribed 'XBT'



Signed by: Craig W. McVean
 Surveyor's Michigan License No.: 39088

Date: 5/20/2004