


Montmorency County Remonumentation

LAND CORNER RECORDATION CERTIFICATE
Filing Requirement of Act 74, Mich. P.A. 1970

For corners in

<u>Montmorency</u> (County)	Located in:	Corner Code #
1. Public Land Survey	T <u>29N</u> R <u>1E</u>	<u>A-11</u>
	T _____ R _____	_____
	T _____ R _____	_____
	T _____ R _____	_____
2. Property Controlling in Section	S _____ T _____ R _____	_____
	S _____ T _____ R _____	_____
3. Miscellaneous Property in Sec.	S _____ T _____ R _____	_____
	S _____ T _____ R _____	_____
4. Lot No. _____, Recorded Plat _____		
5. Private Claims _____		

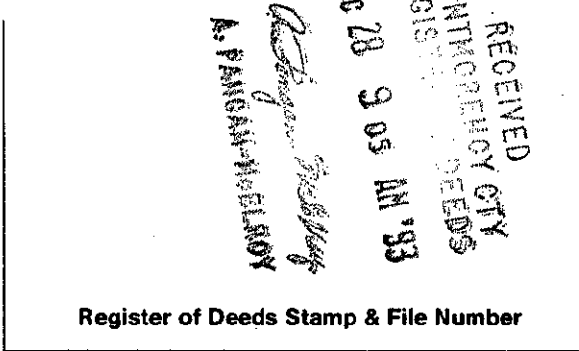

I, Larry G. Beauregard in a field survey on May, 19 93, do hereby certify that under requirements of P.A. 74, Michigan P.A. of 1970, the corner points mentioned in lines 1 and 2 above were in conformance with regulations and rules therefore as required in the current manual of survey instructions of the United States Department of the Interior, Bureau of Land Management or by a decree of a Court of Law and/or that the corner points mentioned in lines 3, 4 and 5 above were in conformance with the rules of the Michigan Board of Land Surveyors or by a Decree of a Court of Law; established, re-established, monumented, re-monumented, recovered, found as expressed below:

NOTE: Not more than 4 corners, all in the same town and range, may be recorded on this certificate.

A	B	C	D	E	F	G	H	I	J	K	L	M
2	6	5	4	3	2	1						
3												
4	7	8	9	10	11	12						
5												
6	18	17	16	15	14	13						
7												
8	19	20	21	22	23	24						
9												
10	30	29	28	27	26	25						
11												
12	31	32	33	34	35	36						
13												

A. Description of original monument and accessories and/or subsequent restoration:

(A-11) GLO Post set by John Hodgson May 1839.
Wit: Pine 14" N 16° E 48 links
G.F. De La Mater P.S. # 693 (Otsego Co. Surveyor) in 1933, fnd. post placed by Hodgson
Wits: (W. Oak 10" N 48° E 27.2') (Y. Pine stp. 24" N 12° E 21.8') (Y. Pine 12" S 59° W no distance).
George D. Henning P.S. #2240 in 1947 fnd. or set Mon. wits: (10" W. Oak N 44° E 26.5') (18" Norway S 64° W 15.02')
Richard C. Dunn P.S. #12020 in 1964 fnd. Mon. (No wits marked) while making the Recorded Plat of West Twin Bay Shores, Rec. L. 2, of Plat P. 102, Otsego Co. Records.
Jim L. Scott P.S. # 8318 (Scott Engineering) in 1963 fnd. Mon. Wits by Henning:
N 48° E 27.2' 10" Oak, N 12° E 21.8' 24" Pine (R) NBT.
Donald E. Marlatt P.S. #18660 in 1985 & 1992 fnd. Mon. & marked Wits: (S 70° W 24" Norway 14.8') (N 50° E 14" Oak 26.5') (S 25° E 9" Oak 15.65') Survey Rec. L. 3, P. 563, Montmorency Co. Rec.

B. Description of corner evidence found and/or method applied in restoring or reestablishing corner:

(A-11) Fnd. 4" dia. Conc. Mon. & Wits by Henning & Marlatt. (No I.D. cap).
(Placed 3" dia. Aluminum cap #18654 marked Montmorency Co. Re-Mon. Cor. on same.)

C. Description of monument for corner and accessories established to perpetuate locating the position of the corner:

(A-11) Sec. Cor. Comm. to Sec's 25, & 36, T29N, RLW & Sec's 30 & 31, T29N, R1E.
4" dia. Conc. Mon. & Re-Mon. cap #18654. Accepted as the best available evidence of the position of the original corner, approved by the Peer Group on September 24, 1993.
S 70° W 14.72' 24" Norway (Ex. Aluminum tag by Henning) (old NBT)
S 35° E 15.79' 9" R. Oak (old NBT)
N 45° W 67.10' 6" Norway
N 35° E 64.63' 4" Norway
(Placed blaze, 20 penny spike & P.S. tag #18654) (typ)

Signed by Larry G. Beauregard Date 12-27-93
Surveyor's Michigan License No. 18654

