

**SURVEY & REMONUMENTATION**

APR 24 1995

**COMMISSION**

Montmorency County Remonumentation

Liber 00012 Page 0122

**LAND CORNER RECORDATION CERTIFICATE**

Filing Requirement of Act 74, Mich. P.A. 1970

For corners in

Montmorency (County)	Located In: Albert Township	Corner Code # B-13 ✓ C-13
1. Public Land Survey	T 29 N R 1 E T 29 N R 1 E T _____ R _____ T _____ R _____	
2. Property Controlling in Section	S _____ T _____ R _____ S _____ T _____ R _____	
3. Miscellaneous Property in Sec.	S _____ T _____ R _____ S _____ T _____ R _____	
4. Lot No. _____	Recorded Plat _____	
5. Private Claims _____		

STATE OF MICHIGAN  
MONTMORENCY COUNTY  
Recorded & Filed

11-10-1994 14:11:12

A. PANGAN-MCELROY  
REGISTER OF DEEDS

Register of Deeds Stamp & File Number

**APPROVED BY  
PEER GROUP**

MAY 13 94

*ASB*

A	B	C	D	E	F	G	H	I	J	K	L	A
2	6	5	4	3	2	1						
3												
4	7	8	9	10	11	12						
5												
6	18	17	16	15	14	13						
7												
8	19	20	21	22	23	24						
9												
10	30	29	28	27	26	25						
11												
12	31	32	33	34	35	36						
13												

I, Don Marlatt in a field survey on November 8, 1994, do hereby certify that under requirements of P.A. 74, Michigan P.A. of 1970, the corner points mentioned in lines 1 and 2 above were in conformance with regulations and rules therefore as required in the current manual of survey instructions of the United States Department of the Interior, Bureau of Land Management or by a decree of a Court of Law and/or that the corner points mentioned in lines 3, 4 and 5 above were in conformance with the rules of the Michigan Board of Land Surveyors or by a Decree of a Court of Law; established, re-established, monumented, re-monumented, recovered, found as expressed below:


**NOTE: Not more than 4 corners, all in the same town and range, may be recorded on this certificate.**

**A. Description of original monument and accessories and/or subsequent restoration:**

- |  |  |
|--|--|
| (B-13) S. 1/4 Cor. Sec. 31, T 29 N, R 1 E<br>Post set by Lewis Clawson Dec. 1839.<br>6" Spr. Pine N 54° W 69 links<br>7" Spr. Pine N 68° E 32 links<br>G. Henning - Survey in July 1974.<br>County Rd. Commission Notes:<br>(Pipe) 8" J. Pine S 30° W 52.94'<br>5" Oak N 5° E 43.46'<br>1" Angle Iron N 55° E 48.41' | (C-13) South Cor. common to Secs. 31 & 32, T 29 N, R 1 E<br>Post set by Lewis Clawson.<br>8" Spr. Pine N 71° W 20 links<br>7" J. Pine N 22° E 22 links<br>County Rd. Commission Notes:<br>5" J. Pine N 42° W 42.5'<br>12" J. Pine S 5° W 13'<br>"X" on stone N 39° E 40.3' |
|--|--|

**B. Description of corner evidence found and/or method applied in restoring or reestablishing corner:**

- |  |   |
|--|---|
| (B-13) S. 1/4 Cor. Sec. 31, T 29 N, R 1 E<br>Found 1" pipe in road.<br>8" B. Oak N 3° E 43.2'<br>14" J. Pine S 32° W 52.8'<br>1/2" rod 33' North - Also 2" pipe<br>N. 1/4 Cor. Sec. 6, 28/1, 36.4' East<br>No evidence of original corner.<br>Accepted as the best available evidence of the reestablishment of the original corner. | (C-13) South Cor. common to Secs. 31 & 32, T 29 N, R 1 E<br>Found 1/2" rod.<br>12" Pine stump South 13.5' (NBT)<br>North Cor. common to Secs. 5 & 6, 28/1, 36.5' East.<br>No evidence of original corner.<br>Accepted as the best available evidence of the reestablishment of the original corner. |
|--|---|

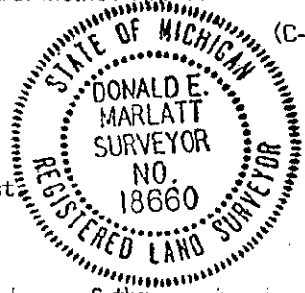

**C. Description of monument for corner and accessories established to perpetuate locating the position of the corner:**

- |  |  |
|--|--|
| (B-13) S. 1/4 Cor. Sec. 31, T 29 N, R 1 E<br>Placed Remonumentation Cap on 1" pipe.<br>13" Oak North 43.67'<br>15" Oak N 47° E 53.35'<br>13" J. Pine S 15° W 43.64'<br>14" J. Pine S 31° W 53.1' (Henning witness) | (C-13) South Cor. common to Secs. 31 & 32, T 29 N, R 1 E<br>Set concrete monument & placed Remonumentation Cap<br>16" Poplar N 20° W 24'<br>24" R. Pine S 63° E 42.0'<br>23" R. Pine S 38° W 12.9'<br>12" Oak S 85° W 28.33'<br>12" Pine stump South 13.5' (NBT) |
|--|--|

Witnesses marked with a 30 penny epike & I.D. tag #18660.

Signed by Donald E Marlatt Date 11-9-1994

Surveyor's Michigan License No. 18660