

SURVEY & REMONUMENTATION

JAN 28 1999

Montmorency County Remonumentation

LAND CORNER RECORDATION CERTIFICATE Liber **00012** Page **0330**
 Filing Requirement of Act 74, Mich. P.A. 1970

SECTION

For corners in

MONTMORENCY (County)	Located In:	Corner Code #
ALBERT TWP.	T 29N R 1E	C - 8
1. Public Land Survey	T _____ R _____	_____
	T _____ R _____	_____
	T _____ R _____	_____
	T _____ R _____	_____
2. Property Controlling in Section	S _____ T _____ R _____	_____
	S _____ T _____ R _____	_____
3. Miscellaneous Property in Sec.	S _____ T _____ R _____	_____
	S _____ T _____ R _____	_____
4. Lot No. _____, Recorded Plat _____		
5. Private Claims _____		

STATE OF MICHIGAN
 MONTMORENCY COUNTY
 Recorded & Filed
 12-07-1998 09:37:37

MARY JO GUEST
 REGISTER OF DEEDS
 Register of Deeds Stamp & File Number

	A	B	C	D	E	F	G	H	I	J	K	L	M
2	6	5	4	3	2	1							
3													
4	7	8	9	10	11	12							
5													
6	18	17	16	15	14	13							
7													
8	19	20	21	22	23	24							
9													
10	30	29	28	27	26	25							
11													
12	31	32	33	34	35	36							
13													

DONALD E MARLATT in a field survey on MAY 19 98

do hereby certify that under requirements of P.A. 74, Michigan P.A. of 1970, the corner points mentioned in lines 1 and 2 above were in conformance with regulations and rules therefore as required in the current manual of survey instructions of the United States Department of the Interior, Bureau of Land Management or by a decree of a Court of Law and/or that the corner points mentioned in lines 3, 4 and 5 above were in conformance with the rules of the Michigan Board of Land Surveyors or by a Decree of a Court of Law; established, re-established, monumented, re-monumented, recovered, found as expressed below:

NOTE: Not more than 4 corners, all in the same town and range, may be recorded on this certificate.

A. Description of original monument and accessories and/or subsequent restoration:
 C-8 1/4 COR. COMMON TO SEC.'S 19 & 20.
 GLO COR. SET BY LEWIS CLASON IN APRIL 1840. Y PINE 10" N53°E 12 L.-SPR.PINE 8" S33°W 19 L.
 SURVEY BY N.C.CALDWELL RLS#12018 4/29/1970. SURVEY BY N.C.CALDWELL OCT. 1968. Fd. 1/2"BAR.
 SURVEY BY N.C.CALDWELL 4/29,1970. WIT. S15°E 74.45' 8"OAK
 SURVEY BY L. BEAUREGARD RLS#18654 OCT. 1970. S12°W 58.5' 10"OAK
 SURVEY BY L. BEAUREGARD 7/11/73. S70°W 57.20' 6"OAK
 SURVEY BY L. BEAUREGARD 9/16/83.
 SURVEY BY D.E.MARLATT RLS#18660 7/17/91. FOUND 1/2"ROD & CAP#12018. N20°W 19"OAK 38.73'
 S20°W 18"OAK 58.85'-N85°E 13"OAK 57.68' - S50°W 12"OAK 51.61'.
 SURVEY BY D.E. MARLATT 10/18/94. L. 10004, P.238.(SAME AS ABOVE).

B. Description of corner evidence found and/or method applied in restoring or reestablishing corner:
 C - 8 1/4 CORNER COMMON TO SEC.'S 19 & 20.
 FOUND 1/2"ROD & CAP #12018.
 N85°E 13"OAK 57.68' - S50°W 12"OAK 51.61' -S77°W 13"OAK 57.2' -N20°W 19"OAK 38.73'
 S20°W 18"OAK 58.85'.


APPROVED BY
 PEER GROUP

JUL 28 98

J.A.B.

C. Description of monument for corner and accessories established to perpetuate locating the position of the corner:

C - 8 1/4 CORNER COMMON TO SEC.'S 19 & 20.
 SET CONC. MONUMENT AND REMON. CAP.
 N20°W 19"OAK 38.73'
 S20°W 18"OAK 58.85'
 N85°E 13"OAK 57.68'
 S50°W 12"OAK 51.61'
 S77°W 13"OAK 57.2'

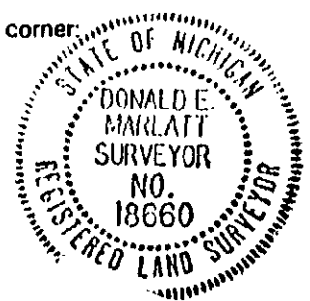

WITNESSES MARKED WITH 40 PENNY SPIKES AND P.S. TAGS #18660.
 APPROVED BY PEER GROUP ON JULY 28, 1998 AS THE BEST AVAILABLE EVIDENCE OF THE OF THE ORIGINAL CORNER.

Signed by Donald E Marlatt

Date 12/4/1998

Surveyor's Michigan License No. 18660